

Keeping you in the flow of things



Commonwealth of Virginia Uniform Water Well Completion Report

Address S/G Assoc.
9701 Burwell Rd.
Norfolk, VA 20181
Phone (703) 754-1714
Location Poplar Hills Sel. 1 Lot 19

Tax Map ID SWP-01-259
VDH Permit 40B-19
VWCB Permit _____
VWCB ID _____
County Stafford

Well Classification IIIA _____ IIIB IIIC _____ IV _____
* Well Data *

General Information
Drilling Method Air Rotary
Depth to Bedrock 50'
Static Water Level 120'
Well Disinfected (Y or N) N

Date Completed 8/30/01
Yield 20 GPM (GPM)
Stabilized Water Level _____
Disinfectant Used _____

Total Depth of Well 215'
Length of Test 1 H.R.
Natural Flow (Rate) N
Amount Used _____

Casing From +1 1/2' To 62 1/2'
Size 6 3/4" ID Material PVC
Weight/Schedule 3.491 # per ft.
.250 wall

From 55' To 175 1/2'
Size 4 1/4" ID Material PVC
Weight/Schedule 2.788 # per ft.
.291 wall

From _____ To _____
Size _____ Material _____
Weight/Schedule _____

Gravel Pack From _____ To _____
Hole size _____
_____ from _____ to _____ ft.
From 62 1/2' To 0
Bore Hole Size 10" x 62 1/2'
Type BENTONITE E-2 seal
Method pressure grout from bottom to top

From _____ To _____
" from _____ to _____ ft.
From _____ To _____
Bore Hole Size _____
Type _____
Method _____

From _____ To _____
" from _____ to _____ ft.
From _____ To _____
Bore Hole Size _____
Type _____
Method _____

Water Zones or Screened Intervals
From 175 1/2' To 215'
Mesh Size .020 Diam 4 1/2"
From _____ To _____
Mesh Size _____ Diam _____

From _____ To _____
Mesh Size _____ Diam _____
* Use Data *

Private Well Domestic Agricultural _____ Industrial _____ Monitoring _____
Public Well Community _____ Non Community _____

* Abandonment Information *


Bored or Dig Wells
Casing Removed, Y or N? _____
Depth to which casing was removed: _____
Depth and Type of Fill: _____
Source of Fill: _____
Removal Plugs: From _____ to _____ From _____ to _____

Wells other than Bored Wells
Casing removed, Y or N? _____
Depth to which casing was removed: _____
Applicable, depth(s), and type of gravel/sand fill: _____
Source of gravel or sand: _____
Cement: From _____ to _____ From _____ to _____

Method of permanently marking location:
1 Installed watertight top

Depth Description of Formation or Sediment

0	20'	red / brown sandy clay
0	35'	tan sandy clay
15	50'	grey sandy clay
0	140'	grey / brown sandy clay
70	215'	brown sand (coarse) w/ shells

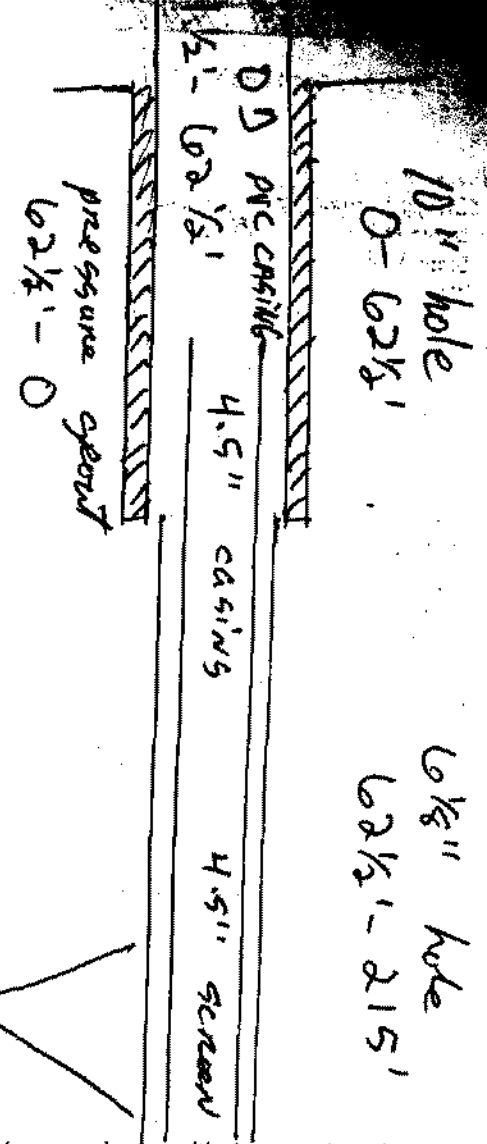

20 + GPM
190' - 215'

(Use additional Sheets if necessary)

The information contained here is true and that this well was installed and constructed in accordance with the permit and that the well complies with all applicable state and local regulations, ordinances and laws.

ARTESIAN WATER WELLS, INC.
 11412 GORDON RD
 PRUKA VA 22407
 540-785-8163

Signature Wade N. Duff
 8/30/01 Representing A W W I

Contractors License Number 2705-046112