

Commonwealth of Virginia
Uniform Water Well Completion Report



Owner SYG Assoc.
Address 9701 Burwell Rd.
Norcross, Va VA 20151
Phone (703) 754-1714
Location Poplar Hills Sec. 1 Lot # 27

Tax Map ID 40 B-27
VDH Permit SWP-01-261
VWCB Permit _____
VWCB ID _____
County Stafford

Well Classification IIIA _____ IIIB IIIC _____ IV _____
* Well Data *

General Information

Drilling Method Air rotary Date Completed 9/5/01 Total Depth of Well 120'
Depth to Bedrock 50' hard clay Yield 30+ (GPM) Length of Test 1 hr.
Static Water Level 70' Stabilized Water Level _____ Natural Flow (Rate) N
Well Disinfected (Y or N) N Disinfectant Used _____ Amount Used _____

Casing From +1 1/2' To 58 1/2' From _____ To _____ From _____ To _____
Size 6 1/4" material PVC Size _____ Material _____ Size _____ Material _____
Weight/Schedule 3.491 lb/ft. 250 wall Weight/Schedule _____ Weight/Schedule _____

Gravel Pack From _____ To _____ From _____ To _____ From _____ To _____

Hole size _____ " from _____ to _____ ft. _____ " from _____ to _____ ft. _____ " from _____ to _____ ft.

From 58 1/2' To 0 From _____ To _____ From _____ To _____
Bore Hole Size 10" x 58 1/2' Bore Hole Size _____ Bore Hole Size _____
Type Bentonite F-2 seal Type _____ Type _____
Method pressure grout from bottom to top Method _____ Method _____

Water Zones or Screened Intervals
From 80' To 120' From _____ To _____ From _____ To _____
Mesh Size 200 Diam 4 1/2" Mesh Size _____ Diam _____ Mesh Size _____ Diam _____
From _____ To _____ From _____ To _____ From _____ To _____
Mesh Size _____ Diam _____ Mesh Size _____ Diam _____ Mesh Size _____ Diam _____

* Use Data *

Private Well: Domestic Agricultural _____ Industrial _____ Monitoring _____
Public Well: Community _____ Non Community _____


* Abandonment Information *

Bored or Dug Wells
Casing Removed, Y or N? _____
If Y, Depth to which casing was removed: _____
Depth and Type of Fill: _____
Source of Fill _____
Bentonite Plugs From _____ to _____ From _____ to _____

Wells other than Bored Wells
Casing removed, Y or N? _____
Depth to which casing was removed: _____
Applicable, depth(s), and type of gravel/sand fill: _____
Source of gravel or sand: _____
Cement: From _____ to _____ From _____ to _____

Method of permanently marking location: Installed watertight top

Depth	Description of Formation or Sediment
0 - 20'	brown sandy clay
20' - 30'	tan sandy clay
30' - 50'	grey sandy clay w/shells
50' - 90'	grey/green hard clay
90' - 120'	brown coarse sand

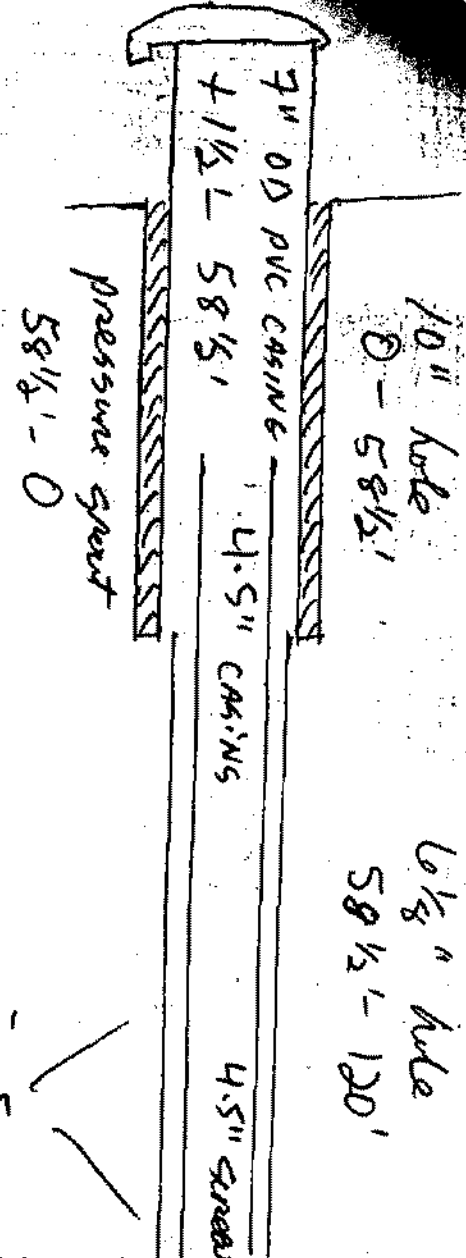

90'-120'
30+GPM

(Use additional Sheets if necessary)

I certify that the information contained here is true and that this well was installed and constructed in accordance with the permit and that the well complies with all applicable state and local regulations, ordinances and laws.

Name ARTESIAN WATER WELLS, INC.
 Address 11412 GORDON RD
PURCELL VA 22407
 Phone 540-785-8163

Dillers Signature Wade A. Smith
 Date 9/5/01 Representing A.W.W.I.

Virginia Contractors License Number 2705-046112