


WATER WELL COMPLETION REPORT

(Certificate of Completion)

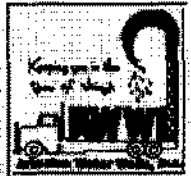

Owner
 Well Designation of #
 Address

 Phone

PWS/ID #
 Tax Map ID #
 Subdivision
 Section/Block
 Lot/GPIN #
 Long/Lat
 Class/Well

Drilling Contractor Artesian Water Wells, Inc
 Address 11412 Gordon Road
 Fredericksburg, VA 22407
 Phone (540) 785-8163

Well Location: (feet/miles) (direction) of and
 feet/miles (direction) of
 (If possible please include map showing location marked)

Date Started Date Completed Type of Rig

1. Well Data:

New Rework Deepened

Total Depth ft
 Depth to Bedrock ft
 Hole size (Also include reamed zones)
 inches to ft
 inches to ft
 inches to ft

Gravel Pack
 Size From to ft
 Size From to ft
 Grout
 From to ft., Type
 From to ft., Type

Casing size (ID) and material

inches to ft
 Material
 Wt. per ft or wall thickness in
 inches to ft
 Material
 Wt. per ft or wall thickness in
 inches to ft
 Material
 Wt. per ft or wall thickness in

Screen size and mesh for each zone (where applicable)

inches to ft
 Mesh size Type
 inches to ft
 Mesh size Type
 inches to ft
 Mesh size Type
 inches to ft
 Mesh size Type

2. Water Data:

Water Temperature _____
 Static water level (unpumped level-measured) ft
 Stabilized measured pumping water level ft
 Stabilized yield gpm after hours
 Natural Flow: Yes No Flow rate gpm
 Comment on Quality

3. Water Zones:

From To
 From To From To

4. Pump Data:

Type Rated H.P.
 Intake depth Capacity at head
 Model No.

5. Disinfection: Well disinfected?

Yes No
 Date Disinfectant used
 Amount Hours used

6. Abandonment:


Date Casing pulled?
 Chlorinated well (explain method)
 Plugging grout From to material

Can Homes

(Use Additional Sheets If Necessary)

Depth (Feet)		Type of Rock or Soil (Color, Material, Fossils, Hardness, Etc.)	Remarks (Water, Caving, Cavities, Broken, Cors, Shot, Etc.)
From	To		
0	10	Brown Sandy Clay	
10	40	Tan Sandy Clay	
40	50	Sandy Gray Clay	
50	100	Gray-Green Clay	
100	230	Gray Sandy Clay w/ Shells	
230	260	White Sand	
240	260	Water @ 60+ GPM	

Diagram of Well Construction

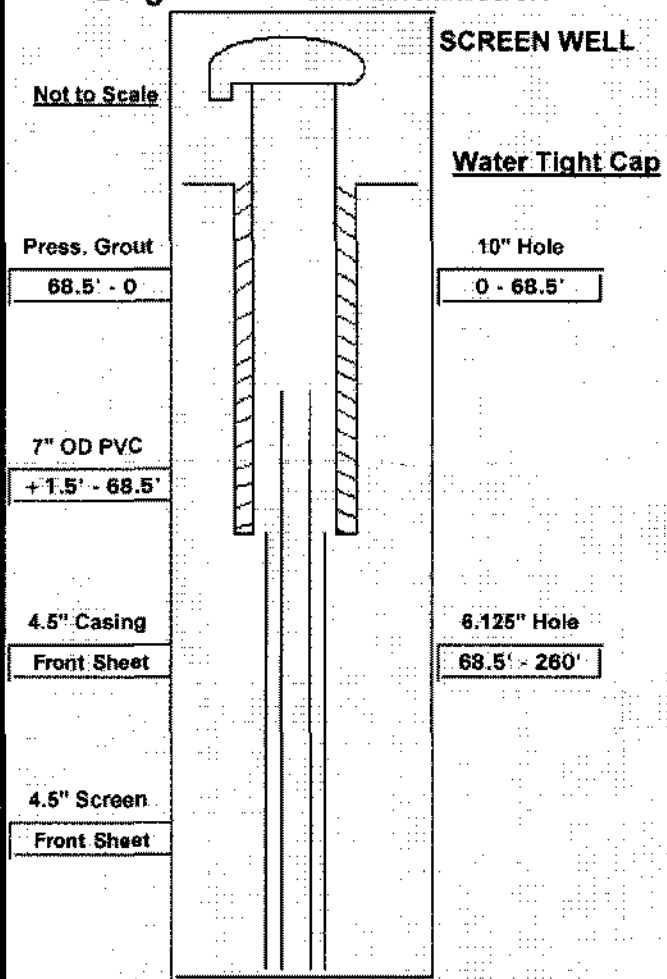

8. Use Data

Type of use: Drinking Livestock Watering Irrigation Food Processing Household
 Manufacturing Fire Safety Cleaning Recreation Aesthetic Cooling or Heating
 Injection Other
 Type of Facility: Domestic Public Water Supply Public Institution Farm Industry
 Commercial Other

9. Wellhead: Type well seal Water Tight Cap Pressure Tank gal. Loc
 Sample tap Measurement port Well Vent Pressure relief valve Gate valve
 Check valve (when required) Electrical disconnect switch on power supply
 10. Well lot dedicated? Size ft. x ft.: Well house? Distance to nearest pollutant source
 Type Distance to nearest property line ft., Building ft.
 11. Water Service Pipe: Checked under P.S.I. for minutes. Pipe size inches. Material
 Installer Date

12. I certify that the information contained herein is true and correct and that this well has been installed and constructed in accordance with the requirements for well constructions specified in compliance with appropriate county or independent city ordinances and the laws and rules of the Commonwealth of Virginia.

Signature Wade N. Smith (Seal), Date 12-27-01 License No. 2705-046112
 (Well Driller or Authorized Person)