


Owner BYG Associates Inc

7. Drillers Log (Use Additional Sheets if Necessary)

Depth (Feet) From To	Type of Rock or Soil (Color, Material, Fossils, Hardness, Etc.)		Remarks (Water, Gassing, Cavities, Strata, Core, Etc.)
0 20		Brown Sandy Clay	
20 45		Tan Clay	
45 80		Gray Sandy Clay w/ Shells	
80 100		Gray Green Clay	
100 180		White Sand	
180 180		Water @ 25+ GPM	

Diagram of Well Construction

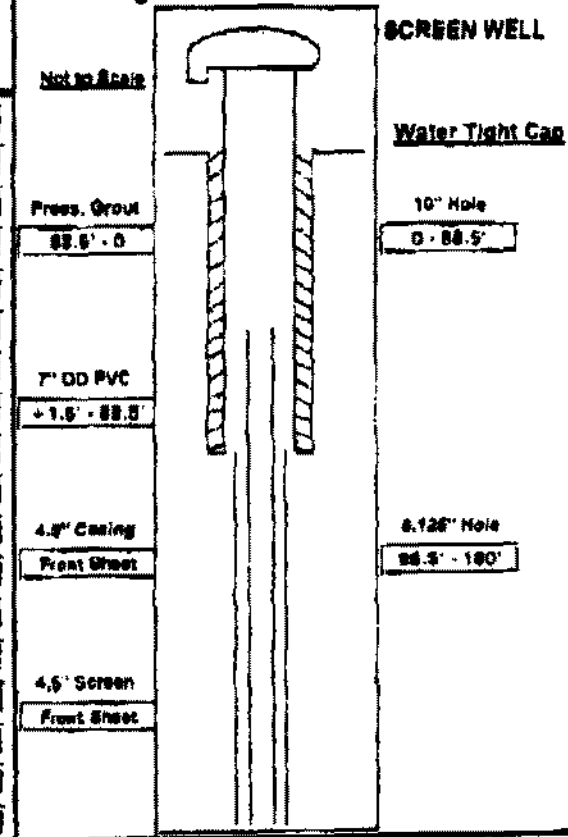

8. Use Data

Type of use: Drinking Livestock Watering Irrigation Food Processing Household
 Manufacturing Fire Safety Cleaning Recreation Aesthetic Cooling or Heating
 Injection Other
 Type of Facility: Domestic Public Water Supply Public Institution Farm Industry
 Commercial Other

9. Wellhead: Type well seal

Water Tight Cap Pressure Tank gal. Loc
 Sample tap Measurement port Well Vent Pressure relief valve Gate valve
 Check valve (when required) Electrical disconnect switch on power supply

10. Well lot dedicated?

Size ft. x ft. Well house? Distance to nearest pollutant source
 Type Distance to nearest property line ft. Building ft.

11. Water Service Pipe: Checked under

P.S.I. for minutes. Pipe size inches. Material
 Installer Date

12. I certify that the information contained herein is true and correct and that this well has been installed and constructed in accordance with the requirements for well constructions specified in compliance with appropriate county or independent city ordinances and the laws and rules of the Commonwealth of Virginia.