


WATER WELL COMPLETION REPORT

(Certificate of Completion)

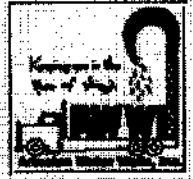

Owner Name: Bobby Cline
Address: PO Box 89
City: Brooks, Virginia
Phone: 557-5114

PWS/ID #: SWP-01-467
Tax Map ID #: 40-51C
Subdivision: Caldwell Est.
Section/Block:
Lot/GPIN #: Lot 1
Long/Lat:
Class/Well: III B

Drilling Contractor: Artesian Water Wells, Inc
Address: 11412 Gordon Road
Fredericksburg, VA 22407
Phone: (540) 785-8183

Well Location: (feet/miles) (direction) of and
(If possible please include map showing location marked)

Date Started: 4-2-02 Date Completed: 4-2-02 Type of Rig: Air Rotary

1. Well Data:

New Rework Deepened

Total Depth: 200 ft
Depth to Bedrock: 60 ft

Hole size (Also include reamed zones)

10	inches	0	to	68.5	ft
8.125	inches	68.5	to	200	ft

Gravel Pack
Size From to ft

Grout
From 68.5 to 0 ft. Type Bentonite

Casing size (ID) and material

6.25	Inches	+1.5	to	68.5	ft
Material: PVC					
Wt. per ft: 3.491 or wall thickness .250 in					
4.2	Inches	60	to	160	ft
Material: PVC					
Wt. per ft: 2.788 or wall thickness .291 in					

2. Water Data:

Water Temperature
Static water level (unpumped level-measured): 80 ft
Stabilized measured pumping water level: ft
Stabilized yield: 30+ gpm after 1 hours
Natural Flow: Yes No Flow rate: gpm
Comment on Quality: Clear

3. Water Zones:

From 170 To 200

4. Pump Data:

Type: Rated H.P.:
Intake depth: Capacity: at head
Model No.:

5. Disinfection: Well disinfected?

Yes No
Date: Disinfectant used:
Amount: Hours used:

6. Abandonment:

Date: Casing pulled?
Chlorinated well (explain method):
Plugging grout From to material


Screen size and mesh for each zone (where applicable)

4.2	Inches	160	to	200	ft
Mesh size: .020 Type: PVC					

Additional Sheets (if Necessary)

Depth (Feet)		Type of Rock or Soil (Color, Material, Fossils, Hardness, Etc.)	Remarks (Water, Caving, Cavities, Broken, Core, Shot, Etc.)
From	To		
0	30	Brown Sandy Clay	
30	60	Brown Sand	
60	170	Gray Green Clay	
170	200	White Sand	
170	200		Water @ 30+ GPM

Diagram of Well Construction

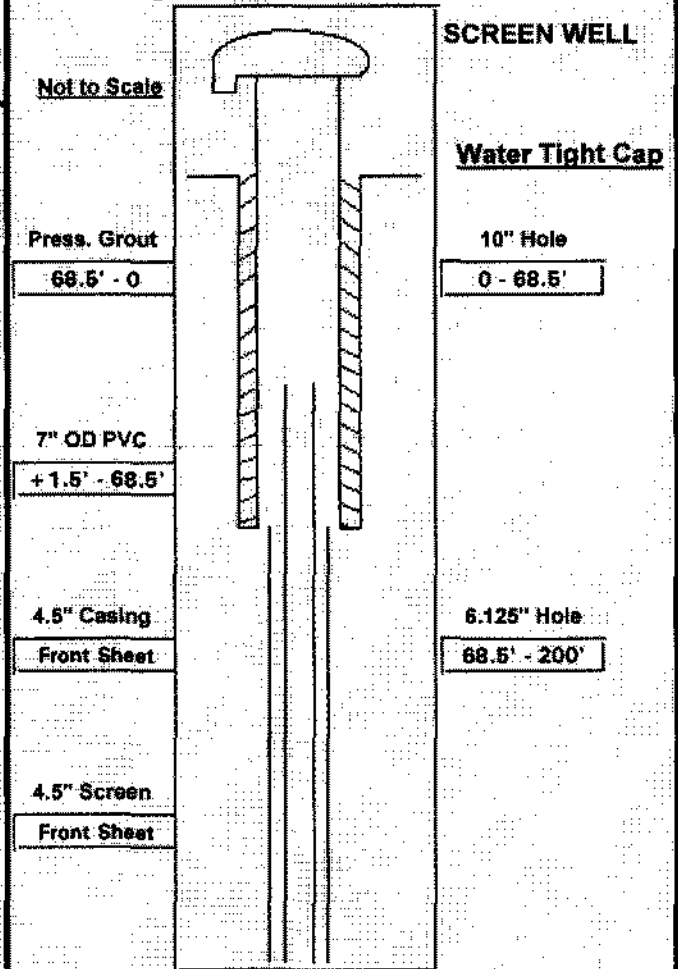

8. Use Data

Type of use: Drinking Livestock Watering Irrigation Food Processing Household
 Manufacturing Fire Safety Cleaning Recreation Aesthetic Cooling or Heating
 Injection Other _____

Type of Facility: Domestic Public Water Supply Public Institution Farm Industry
 Commercial Other _____

9. Wellhead: Type well seal Water Tight Cap Pressure Tank gal. Loc _____
 Sample tap Measurement port Well Vent Pressure relief valve Gate valve
 Check valve (when required) _____ Electrical disconnect switch on power supply _____

10. Well lot dedicated? Size _____ ft. x _____ ft. Well house? Distance to nearest pollutant source _____
 Type _____ Distance to nearest property line _____ ft. Building _____ ft.

11. Water Service Pipe: Checked under _____ P.S.I. for _____ minutes. Pipe size _____ inches. Material _____
 Installer _____ Date _____

12. I certify that the information contained herein is true and correct and that this well has been installed and constructed in accordance with the requirements for well constructions specified in compliance with appropriate county or independent city ordinances and the laws and rules of the Commonwealth of Virginia.

Signature Wade H. [Signature] (Seal), Date 4-16-02 License No. 2705-046112
 (Well Driller or Authorized Person)