

Commonwealth of Virginia  
Uniform Water Well Completion Report



Owner Richmond American Homes  
Address 3701 Pender Dr. Suite 208  
Fairfax VA 22030  
Phone (703) 352-0800  
Location Poplar Hills Lot # 9

Tax Map ID 40B-9  
VDH Permit JWP-01-99  
VWCB Permit \_\_\_\_\_  
VWCB ID \_\_\_\_\_  
County Stafford

40B-1-9

Well Classification IIIA \_\_\_\_\_ IIIB  IIIC \_\_\_\_\_ IV \_\_\_\_\_  
\* Well Data \*

General Information

Drilling Method Air Rotary  
Depth to Bedrock 50'  
Static Water Level 40'  
Well Disinfected (Y or N) N

Date Completed 6/27/01  
Yield 20+ (GPM)  
Stabilized Water Level \_\_\_\_\_  
Disinfectant Used \_\_\_\_\_

Total Depth of Well 180'  
Length of Test 1 hr.  
Natural Flow (Rate) N  
Amount Used \_\_\_\_\_

Casing From +1 1/2' To 128 1/2'  
Size 6 1/4" ID Material PVC  
Weight/Schedule 3.491 # per ft.  
1250 wall

From 100' To 140'  
Size 4 1/2" ID Material PVC  
Weight/Schedule 2.788 # per ft.  
.291 wall

From \_\_\_\_\_ To \_\_\_\_\_  
Size \_\_\_\_\_ Material \_\_\_\_\_  
Weight/Schedule \_\_\_\_\_

Gravel Pack

From \_\_\_\_\_ To \_\_\_\_\_

From \_\_\_\_\_ To \_\_\_\_\_

From \_\_\_\_\_ To \_\_\_\_\_

Hole size \_\_\_\_\_  
" from \_\_\_\_\_ to \_\_\_\_\_ ft.

" from \_\_\_\_\_ to \_\_\_\_\_ ft.

" from \_\_\_\_\_ to \_\_\_\_\_ ft.

From 60' To 0  
Bore hole size 10 1/2" x 128 1/2'  
Type Bentonite 1-2 seal  
Method pressure grout from  
bottom to top

From \_\_\_\_\_ To \_\_\_\_\_  
Bore Hole Size \_\_\_\_\_  
Type \_\_\_\_\_  
Method \_\_\_\_\_

From \_\_\_\_\_ To \_\_\_\_\_  
Bore Hole Size \_\_\_\_\_  
Type \_\_\_\_\_  
Method \_\_\_\_\_

Water Zones or Screened Intervals

From 140' To 180'  
Mesh Size 100 Diam 4 1/2"  
From \_\_\_\_\_ To \_\_\_\_\_  
Mesh Size \_\_\_\_\_ Diam \_\_\_\_\_

From \_\_\_\_\_ To \_\_\_\_\_  
Mesh Size \_\_\_\_\_ Diam \_\_\_\_\_  
\* Use Data \*

Private Well  Domestic  Agricultural \_\_\_\_\_ Industrial \_\_\_\_\_ Monitoring \_\_\_\_\_  
Public Well \_\_\_\_\_ Community \_\_\_\_\_ Non Community \_\_\_\_\_

\* Abandonment Information \*

Bored or Bore Wells

Casing Removed, Y or N? \_\_\_\_\_  
Depth to which casing was removed: \_\_\_\_\_  
Depth and type of fill: \_\_\_\_\_  
Source of fill: \_\_\_\_\_  
Reinforce Rings From \_\_\_\_\_ to \_\_\_\_\_ From \_\_\_\_\_ to \_\_\_\_\_

Wells other than Bored Wells

Casing removed, Y or N? \_\_\_\_\_  
Depth to which casing was removed: \_\_\_\_\_  
Applicable, depth(s), and type of gravel/sand fill: \_\_\_\_\_  
Source of gravel or sand: \_\_\_\_\_  
Cement: From \_\_\_\_\_ to \_\_\_\_\_ From \_\_\_\_\_ to \_\_\_\_\_


Method of permanently marking location: \_\_\_\_\_

Installed watertight top

Drillers Log **NOT TO SCALE**

Depth Description of Formation or Sediment Remarks

0	10'	brown sandy clay
10'	20'	red sandy clay
20'	50'	TAN sandy clay
50'	75'	grey / green clay
75'	105'	grey fine sand w/ shells
105'	135'	grey / green clay
135'	180'	brown sand

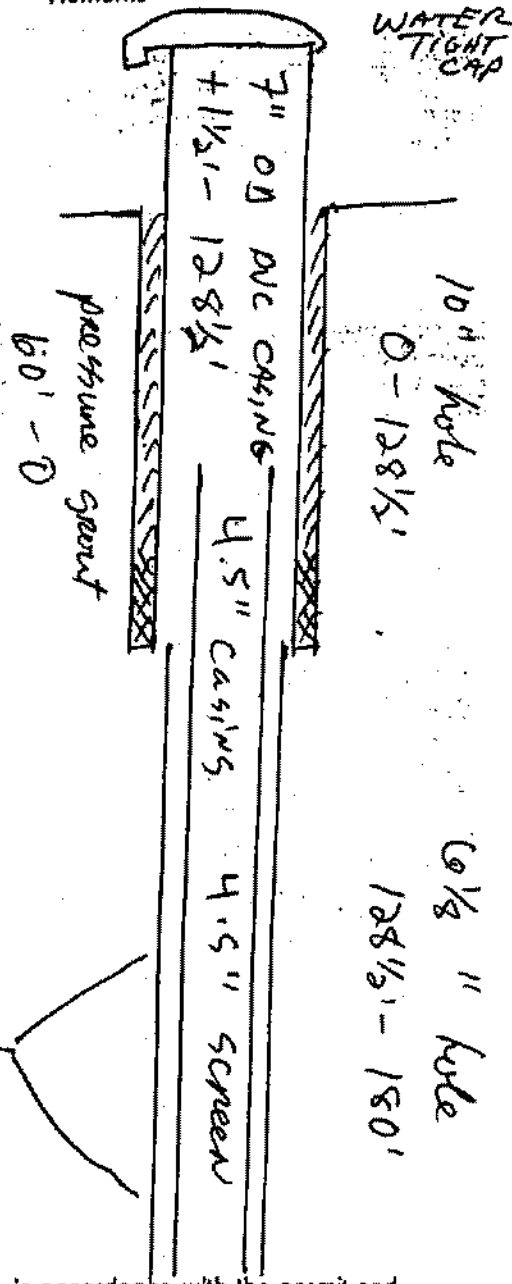

135' - 170'  
20 + GPM

(User additional Sheets if necessary)

I hereby certify that the information contained here is true and that this well was installed and constructed in accordance with the permit and that the well complies with all applicable state and local regulations, ordinances and laws.

By ARTESIAN WATER WELLS, INC.  
 Address 11412 GORDON RD  
PURCELL VA 22407  
 Phone 540-755-8163

By Wade N. Smith  
 Date 6/27/01 Representing A.W.W.

Contractors License Number 2705-046112

Department  
 Comments  
 JRD