


WATER WELL COMPLETION REPORT

(Certificate of Completion)

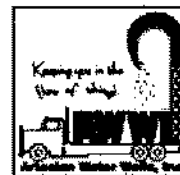

City/City
Owner
Well Designation of #
Address

Phone

PWS/ID #
Tax Map ID #
Subdivision
Section/Block
Lot/GPIN #
Long/Lat
Class/Well

Drilling Contractor
Address

Phone

Well Location: (feet/miles) (direction) of and
 feet/miles (direction) of
(If possible please include map showing location marked)

Date Started Date Completed Type of Rig

1. Well Data:

New Rework Deepened

Total Depth ft
Depth to Bedrock ft
Hole size (Also include reamed zones)
 inches to ft
 inches to ft
 inches to ft

Gravel Pack
Size From to ft
Size From to ft
Grout
From to ft., Type
From to ft., Type

Casing size (ID) and material

inches to ft
Material
Wt. per ft or wall thickness in
 inches to ft
Material
Wt. per ft or wall thickness in
 inches to ft
Material
Wt. per ft or wall thickness in

2. Water Data: Water Temperature

Static water level (unpumped level-measured) ft
Stabilized measured pumping water level ft
Stabilized yield gpm after hours
Natural Flow: Yes No Flow rate gpm
Comment on Quality

3. Water Zones: From To

From To From To

4. Pump Data: Type Rated H.P.
Intake depth Capacity at TD head
Model No.

Screen size and mesh for each zone (where applicable)

inches to ft
Mesh size Type
 inches to ft
Mesh size Type
 inches to ft
Mesh size Type
 inches to ft
Mesh size Type

5. Disinfection: Well disinfected? Yes No

Date Disinfectant used
Amount Hours used

6. Abandonment: Date Casing pulled?

Chlorinated well (explain method)

Plugging grout From to material


Homes

Log (Use Additional Sheets If Necessary)

Depth (Feet)		Type of Rock or Soil (Color, Material, Fossils, Hardness, Etc.)	Remarks (Water, Caving, Cavities, Broken, Core, Shot, Etc.)
From	To		
0	40	Brown Sandy Clay	
40	60	Tan Sand	
60	90	Grey Clay	
90	130	Grey Green Clay	
130	160	White Sand	
130	160	Water @ 50+ GPM	

Diagram of Well Construction

Not to Scale

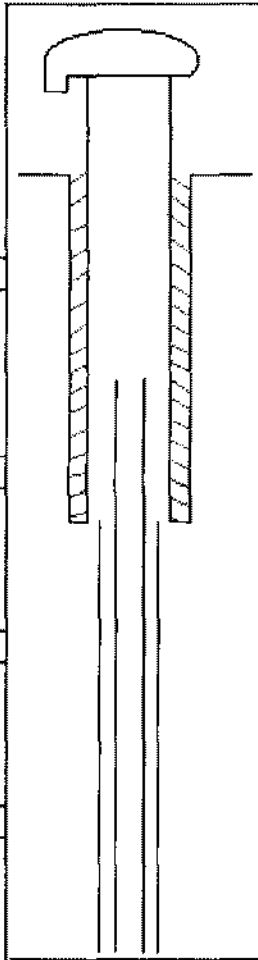

SCREEN WELL

Water Tight Cap

10" Hole

0 - 73.5'

Press. Grout

73.5' - 0

7" OD PVC

+1.5' - 73.5'

4.2" Casing

Front Sheet

6.128" Hole

73.5' - 160'

4.2" Screen

Front Sheet

8. Use Data

Type of use: Drinking Livestock Watering Irrigation Food Processing Household
 Manufacturing Fire Safety Cleaning Recreation Aesthetic Cooling or Heating
 Injection Other

Type of Facility: Domestic Public Water Supply Public Institution Farm Industry
 Commercial Other

9. Wellhead: Type well seal Water Tight Cap Pressure Tank gal. Loc

Sample tap Measurement port Well Vent Pressure relief valve Gate valve
 Check valve (when required) Electrical disconnect switch on power supply

10. Well lot dedicated? Size ft. x ft.: Well house? Distance to nearest pollutant source
 Type Distance to nearest property line ft., Building ft.

11. Water Service Pipe: Checked under P.S.I. for minutes. Pipe size inches. Material
 Installer Date

12. I certify that the information contained herein is true and correct and that this well has been installed and constructed in accordance with the requirements for well constructions specified in compliance with appropriate county or independent city ordinances and the laws and rules of the Commonwealth of Virginia.

Signature Wade N. Smith (Seal), Date 08.29.02 License No. 2705-046112
 (Well Driller or Authorized Person)