


All Political & Social Technologies
Wendmere #4
Stafford
Wendmere Drive
 * Drillers Log *

UNION
 11/10/95
 11/10/95

Depth	Description of Formation or Sediment
0	10 Sandy Red Clay
10	30 yellow sand
30	90 Blue Marl
90	200 Black sand & Shells
200	260 Blue Clay
260	280 Grey sand - water zone
280	288 Brown Clay

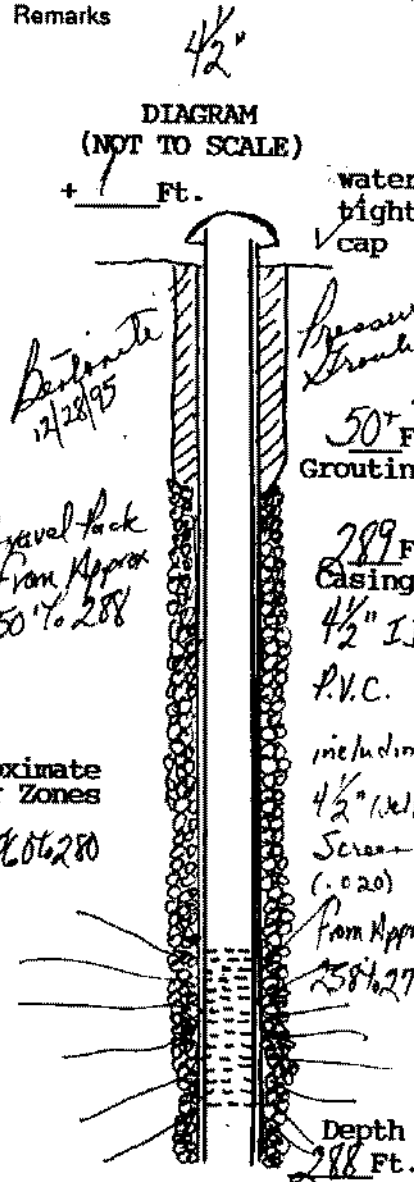

(User additional Sheets if necessary)

I certify that the information contained here is true and that this well was installed and constructed in accordance with the permit and further that the well complies with all applicable state and local regulations, ordinances and laws.

Name JOHN L. DANIELSON, JR., INC.
 Address 4616 HOOD DRIVE
FREDERICKSBURG, VIRGINIA 22408
 Phone (703) 898-6025 / 898-9355

Drillers Signature John L. Danielson, Pres.
 Date 12/28/95 Representing JOHN L. DANIELSON, JR., INC.

Virginia Contractors License Number CLASS A 2701 014084A H/H WNC