

**Commonwealth of Virginia
Uniform Water Well Completion Report**

P. Carter
Construction
Walnut Ridge Drive

 Owner Thomas P. Carter / For Sale
 Address 221 Walnut Ridge Drive
Stafford, Va 22554
 Phone 752-2495
 Location Wooderness #9 / Wooderness Drive off Broad St.
 IF2A
 Well Classification IIIA ITIB IIIC IV
 * Well Data *

Tax Map ID 40A-9
 VDH Permit SWP-96-14
 VWCB Permit _____
 VWCB ID _____
 County STAFFORD
1/26/96 Daniel J. ...
DGI

General Information
 Drilling Method Mid Rotary Date Completed 5/24/96 Total Depth of Well 312
 Depth to Bedrock _____ Yield 25 (GPM) Length of Test approx 4 Hrs
 Static Water Level 20' Stabilized Water Level 200 Natural Flow (Rate) _____
 Well Disinfected (Y or N) _____ Disinfectant Used _____ Amount Used _____

Casing
 From 1 To 267 From 307 To 312 From _____ To _____
 Size 4 1/2 Material P.V.C. Size 4 1/2 Material P.V.C. Size _____ Material _____
 Weight/Schedule SDR 17 Weight/Schedule SDR 17 Weight/Schedule _____

Gravel Pack
 From 50 To 312 From _____ To _____ From _____ To _____
Hole size
8" from 0 to 312 ft. _____" from _____ to _____ ft. _____" from _____ to _____ ft.
Grout
 From 0 To 50+ From _____ To _____ From _____ To _____
 Bore Hole Size 8" Bore Hole Size _____ Bore Hole Size _____
 Type Bentonite Type _____ Type _____
 Method Pressure Grouting Method _____ Method _____

Water Zones or Screened Intervals
 From 267 To 287 From 254 To 308 From _____ To _____
 Mesh Size 20 Diam 4 1/2" (P.V.C.) Mesh Size _____ Diam _____ Mesh Size _____ Diam _____
 From 287 To 307 From _____ To _____ From _____ To _____
 Mesh Size 20 Diam 4 1/2" (P.V.C.) Mesh Size _____ Diam _____ Mesh Size _____ Diam _____

* Use Data *

Private Well: Domestic Agricultural _____ Industrial _____ Monitoring _____
 Public Well: Community _____ Non Community _____

* Abandonment Information *

Bored or Dug Wells
 Casing Removed, Y or N?: _____
 If Y, Depth to which casing was removed: _____
 Depth and Type of Fill: _____
 Source of Fill: _____
 Bentonite Plugs: From _____ to _____ From _____ to _____

Wells other than Bored Wells
 Casing removed, Y or N? _____
 Depth to which casing was removed: _____
 Applicable, depth(s), and type of gravel/sand fill: _____
 Source of gravel or sand: _____
 Cement: From _____ to _____ From _____ to _____



Method of permanently marking location:
 Installed watertight top
 Suggest setting pump @ approx. 220 ft. (Well pumped 15 G.P.M. @ 220 on 5/24/96)

Carter Construction
 Thomas P. Carter

Wanderware #9

Stafford
 Wanderware Drive / off. Brooke Rd
 Drillers Log

Depth	Description of Formation or Sediment	Remarks
0	10	Red Sandy Clay
10	80	Black Sand & Shells
80	110	Grey Clay
110	230	Black Sand & Shells
230	245	Grey Clay
245	254	Grey Sandy clay
254	308	Grey Sand - water zone
308	312	Grey Clay

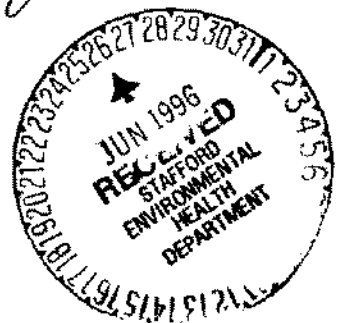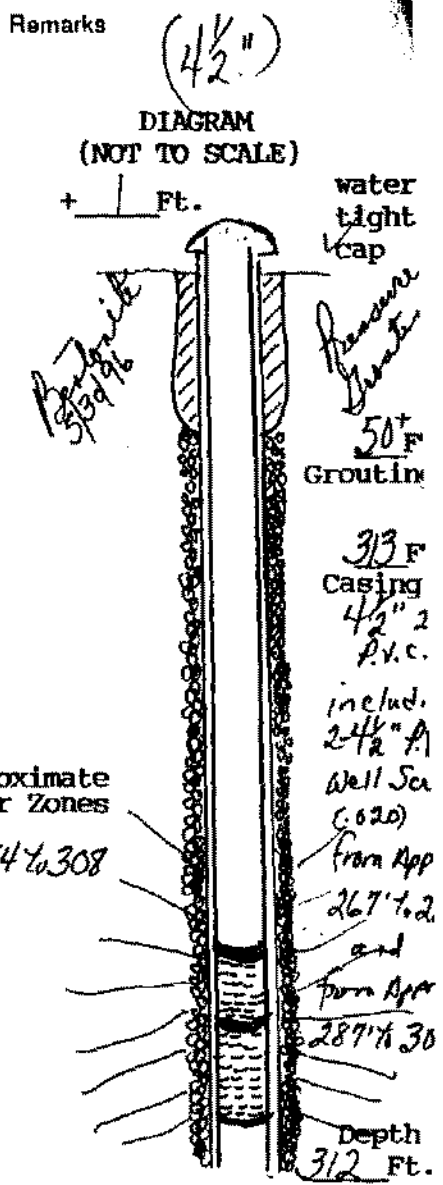

(User additional Sheets if necessary)

I certify that the information contained here is true and that this well was installed and constructed in accordance with the permit and further that the well complies with all applicable state and local regulations, ordinances and laws.

Name JOHN L. DANIELSON, JR., INC.
 Address 4616 HOOD DRIVE
FREDERICKSBURG, VIRGINIA 22408
 Phone 540 (203) 898-6025 / 898-9355

Drillers Signature John L. Danielson, President
 Date 5/30/96 Representing JOHN L. DANIELSON, JR., INC.

Virginia Contractors License Number CLASS A 2701 014084A II/II WVC