

Commonwealth of Virginia  
Uniform Water Well Completion Report

Donald and Angela Mountjoy  
120 S. Kings Crest Dr.  
Stafford, VA 22555

Tax Map ID SWP-97-371  
VDH Permit 40-37  
VWCB Permit \_\_\_\_\_  
VWCB ID \_\_\_\_\_  
County Stafford

Corner of Rte. 630 and Rte. 666

Classification IIIA \_\_\_\_\_ IIIB XXXXX IIIC \_\_\_\_\_ IV \_\_\_\_\_

\* Well Data \*

General Information

Drilling Method <u>Rotary</u>	Date Completed <u>07/22/98</u>	Total Depth of Well <u>255 ft.</u>
Depth to Bedrock _____	Yield <u>10</u> (GPM)	Length of Test <u>4 hrs.</u>
Static Water Level <u>140</u>	Stblzd Water Level <u>165</u>	Natural Flow (rate) _____
Well Disinfected (Y/N) <u>Y</u>	Disinfectant Used <u>chlorine</u>	Amount Used <u>50 PPM</u>

Casing

From <u>+1</u> to <u>238 ft.</u>	From <u>235</u> to <u>245</u>	From _____ to _____
Size <u>4 1/2"</u> Material <u>PVC</u>	Size <u>2"</u> Material <u>Galv</u>	Size _____ Material _____
<del>XXXXX</del> /Schedule <u>40</u>	<del>XXXXX</del> /Schedule <u>40</u>	Weight/Schedule _____

Gravel Pack

From _____ to _____	From _____ to _____	From _____ to _____
---------------------	---------------------	---------------------

Grout

From <u>0</u> to <u>50</u>	From <u>50</u> to <u>238</u>	From <u>238</u> to <u>255</u>
Bore Hole Size <u>8"</u>	Bore Hole Size <u>7"</u>	Bore Hole Size <u>3-7/8"</u>
Type <u>Ben Seal</u>	Type _____	Type _____
Method <u>Pressure</u>	Method _____	Method _____

Water Zones or Screened Intervals

From <u>245</u> to <u>255</u>	From _____ to _____	From _____ to _____
Mesh Size <u>15</u> Diam. <u>2"</u>	Mesh Size _____ Diam. _____	Mesh Size _____ Diam. _____
From _____ to _____	From _____ to _____	From _____ to _____
Mesh Size _____ Diam. _____	Mesh Size _____ Diam. _____	Mesh Size _____ Diam. _____

\* Use Data \*

Private Well: Domestic XXXXX Agricultural \_\_\_\_\_ Industrial \_\_\_\_\_ Monitoring \_\_\_\_\_  
Public Well: Community \_\_\_\_\_ Non Community \_\_\_\_\_

\* Abandonment Information \*

Bored or Dug Wells

Casing Removed, Y or N?: \_\_\_\_\_  
If Y, Depth Removed: \_\_\_\_\_  
Depth and Type of Fill: \_\_\_\_\_  
Source of Fill: \_\_\_\_\_  
Bentonite Plugs: From \_\_\_\_\_ to \_\_\_\_\_  
From \_\_\_\_\_ to \_\_\_\_\_

Wells other than Bored Wells

Casing Removed, Y or N?: \_\_\_\_\_  
If Y, Depth Removed: \_\_\_\_\_  
Depth and type of Fill: \_\_\_\_\_  
Source of Gravel or Sand: \_\_\_\_\_  
Cement: From \_\_\_\_\_ to \_\_\_\_\_  
From \_\_\_\_\_ to \_\_\_\_\_


Method of permanently marking location: \_\_\_\_\_

\*DRILLERS LOG\*

DESCRIPTION OF FORMATION OR SEDIMENT

Brown clay  
 Black sand  
 Gray clay and shells  
 White sand  
 Gray clay  
 Pasty sand  
 Blue sand  
 Gray clay

REMARKS

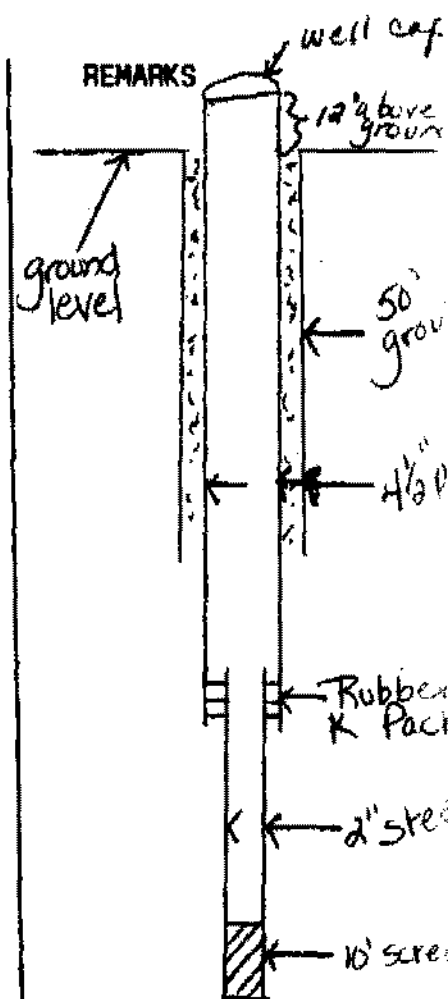

I certify that the information contained here is true and that this well was installed and constructed in accordance with the permit and further that the well complies with all applicable state and local regulations, ordinances and laws.

Name King George Drilling Service, Inc.

Address 881 Macedonia Lane

Colonial Beach, VA 22443

Phone (804) 224-9130

Driller's Signature *J. Lane Jordan - Shepherd*

Date 7-22-98 Representing Kenneth M. Frank, Jr.

Virginia Contractors License Number 2701 023065A