

COMMONWEALTH OF VIRGINIA  
UNIFORM WATER WELL COMPLETION REPORT

Owner Maurice and Peggy Timmons  
Address 1965 Brooke Rd.  
Stafford, VA 22554  
Phone (540) 659-2672  
Location \_\_\_\_\_  
Well Classification: IIIA IIIB XXXX IIIC IV

Tax Map ID 40-24Part  
VDH Permit SWP-98-271  
VWCB Permit \_\_\_\_\_  
VWCB ID \_\_\_\_\_  
County Stafford

\* Well Data \*

General Information:

Drilling Method Rotary Date Completed 11/23/98 Total Depth of Well 195 ft.  
Depth to Bedrock \_\_\_\_\_ Yield 50 (GPM) Length of Test 4 hours  
Static Water Level 30 Stblzed Water Level 55 Natural Flow (rate) \_\_\_\_\_  
Well disinfected Yes Disinfectant Used chlorine Amount Used 50 PPM

Casing:

From +1 to 182 From 175 to 185 From \_\_\_\_\_ to \_\_\_\_\_  
Size 4 1/2" Mat'l PVC Size 2" Mat'l Galv. Size \_\_\_\_\_ Mat'l \_\_\_\_\_  
~~XXXX~~/Schedule 40 ~~XXXX~~/Schedule 40 Weight/Schedule \_\_\_\_\_

Gravel Pack:

From \_\_\_\_\_ to \_\_\_\_\_ From \_\_\_\_\_ to \_\_\_\_\_ From \_\_\_\_\_ to \_\_\_\_\_

Grout:

From 0 to 70 From 70 to 182 From 182 to 195  
Bore Hole Size 8" Bore Hole Size 7" Bore Hole Size 3-7/8"  
Type Benseal Type \_\_\_\_\_ Type \_\_\_\_\_  
Method Pressure Method \_\_\_\_\_ Method \_\_\_\_\_

Water Zones or Screened Intervals:

From 185 to 195 From \_\_\_\_\_ to \_\_\_\_\_ From \_\_\_\_\_ to \_\_\_\_\_  
Mesh Size 15 Diam. 2" Mesh Size \_\_\_\_\_ Diam. \_\_\_\_\_ Mesh Size \_\_\_\_\_ Diam. \_\_\_\_\_  
From \_\_\_\_\_ to \_\_\_\_\_ From \_\_\_\_\_ to \_\_\_\_\_ From \_\_\_\_\_ to \_\_\_\_\_  
Mesh Size \_\_\_\_\_ Diam. \_\_\_\_\_ Mesh Size \_\_\_\_\_ Diam. \_\_\_\_\_ Mesh Size \_\_\_\_\_ Diam. \_\_\_\_\_


\* Use Data \*

Private Well: Domestic XXXXX Agricultural \_\_\_\_\_ Industrial \_\_\_\_\_ Monitoring \_\_\_\_\_  
Public Well: Community \_\_\_\_\_ Non-Community \_\_\_\_\_

811  
150 C OLDE GREEN  
P.O. BOX 781

\* DRILLERS LOG \*

DEPTH	DESCRIPTION OF FORMATION OR SEDIMENT
0- 20	Sand
20- 45	Black sand and shells
45-100	Green and brown clay
100-120	Blue sand
120-150	Green and brown clay
150-180	Pasty sand
180-195	White sand

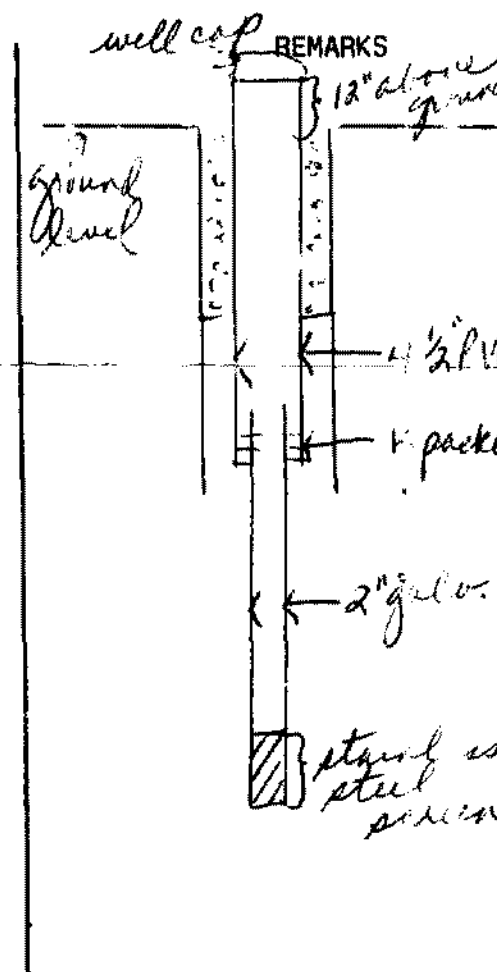

I certify that the information contained here is true and that this well was installed and constructed in accordance with the permit and further that the well complies with all applicable state and local regulations, ordinances and laws.

Name King George Drilling Service, Inc.

Address 861 Macedonia Lane  
Colonial Beach, VA 22443

Phone (804) 224-9130

Driller's Signature *J. Lane Jordan - Shepherd*

Date 11/24/98 Representing Kenneth M. Frank, Jr.

Virginia Contractor's License Number 2701 023065A