

Commonwealth of Virginia  
Uniform Water Well Completion Report

*Under Construction*  
106 Walnut Ridge Drive  
Stafford, VA 22554  
752-2475  
Owner Tom Carter / For Sale  
Address \_\_\_\_\_  
Phone \_\_\_\_\_  
Location Windsor Drive - (Windsor #14)  
approx 2 miles E of Inter 7 608  
Well Classification IIIA \_\_\_\_\_ IIIB  IIIC \_\_\_\_\_ IV \_\_\_\_\_  
\* Well Data \*

Tax Map ID 40A-14  
VDH Permit WS-93-310  
VWCB Permit \_\_\_\_\_  
VWCB ID \_\_\_\_\_  
County Stafford  
11/17/93 Daniel J. Joselyn  
11/15/93 J.J. Thompson

General Information  
Drilling Method Air Rotary  
Depth to Bedrock approx 80'  
Static Water Level \_\_\_\_\_  
Well Disinfected (Y or N) \_\_\_\_\_

Date Completed 6/8/94  
Yield 20 (GPM)  
Stabilized Water Level approx 160'  
Disinfectant Used \_\_\_\_\_

Total Depth of Well 260  
Length of Test 1 Hr.  
Natural Flow (Rate) \_\_\_\_\_  
Amount Used \_\_\_\_\_

Casing  
From +1 To 80  
Size 6 1/4 Material P.V.C.  
Weight/Schedule S.D.R. 27

From 80 To 140  
Size 6 3/8 Material P.V.C.  
Weight/Schedule S.D.R. 21

From 130 To 225  
Size 4 Material P.V.C.  
Weight/Schedule Sch. 40

Gravel Pack  
From \_\_\_\_\_ To \_\_\_\_\_  
Hole size 10" from 0 to 140 ft.  
Grout  
From 0 To 60+  
Bore Hole Size 10  
Type Bentonite  
Method Pressure Grouting

From \_\_\_\_\_ To \_\_\_\_\_  
Hole size 6 1/8" from 140 to 200 ft.  
Grout  
From \_\_\_\_\_ To \_\_\_\_\_  
Bore Hole Size \_\_\_\_\_  
Type \_\_\_\_\_  
Method \_\_\_\_\_

From \_\_\_\_\_ To \_\_\_\_\_  
Hole size \_\_\_\_\_ from \_\_\_\_\_ to \_\_\_\_\_ ft.  
Grout  
From \_\_\_\_\_ To \_\_\_\_\_  
Bore Hole Size \_\_\_\_\_  
Type \_\_\_\_\_  
Method \_\_\_\_\_

Water Zones or Screened Intervals  
From 225 To 245  
Mesh Size 20 Diam 4" P.V.C.  
From \_\_\_\_\_ To \_\_\_\_\_  
Mesh Size \_\_\_\_\_ Diam \_\_\_\_\_

approx water zone  
From 222 To 248  
Mesh Size \_\_\_\_\_ Diam \_\_\_\_\_  
From \_\_\_\_\_ To \_\_\_\_\_  
Mesh Size \_\_\_\_\_ Diam \_\_\_\_\_

From \_\_\_\_\_ To \_\_\_\_\_  
Mesh Size \_\_\_\_\_ Diam \_\_\_\_\_  
From \_\_\_\_\_ To \_\_\_\_\_  
Mesh Size \_\_\_\_\_ Diam \_\_\_\_\_

\* Use Data \*

Private Well: Domestic  Agricultural \_\_\_\_\_ Industrial \_\_\_\_\_ Monitoring \_\_\_\_\_  
Public Well: Community \_\_\_\_\_ Non Community \_\_\_\_\_

\* Abandonment Information \*

Bored or Dug Wells  
Casing Removed, Y or N? \_\_\_\_\_  
If Y, Depth to which casing was removed: \_\_\_\_\_  
Depth and Type of Fill: \_\_\_\_\_  
Source of Fill \_\_\_\_\_  
Bentonite Plugs: From \_\_\_\_\_ to \_\_\_\_\_ From \_\_\_\_\_ to \_\_\_\_\_

Wells other than Bored Wells  
Casing removed, Y or N? \_\_\_\_\_  
Depth to which casing was removed: \_\_\_\_\_  
Applicable, depth(s), and type of gravel/sand fill: \_\_\_\_\_  
Source of gravel or sand: \_\_\_\_\_  
Cement: From \_\_\_\_\_ to \_\_\_\_\_ From \_\_\_\_\_ to \_\_\_\_\_

Method of permanently marking location:  
 Installed watertight top  
Suggest setting pump @ approx. 180 ft.  
Casing telescopes to 4" @ approx 130'  
Suggest keeping centralizers & torque arrestors out of casing.

Tom Carter

Wendover #14

Stefford

#1608

\* Drillers Log \*


Depth

Description of Formation or Sediment

Remarks

0	3	Topsoil
3	30	Red Sandy Clay
30	155	Black Sand & Shells
155	170	Brown Clay
170	200	Sandy Grey Clay
200	220	Brown Clay
220	222	Sandy Grey Clay
222	248	Grey Sand & Clay
248	260	Brown Clay.

DIAGRAM (NOT TO SCALE)

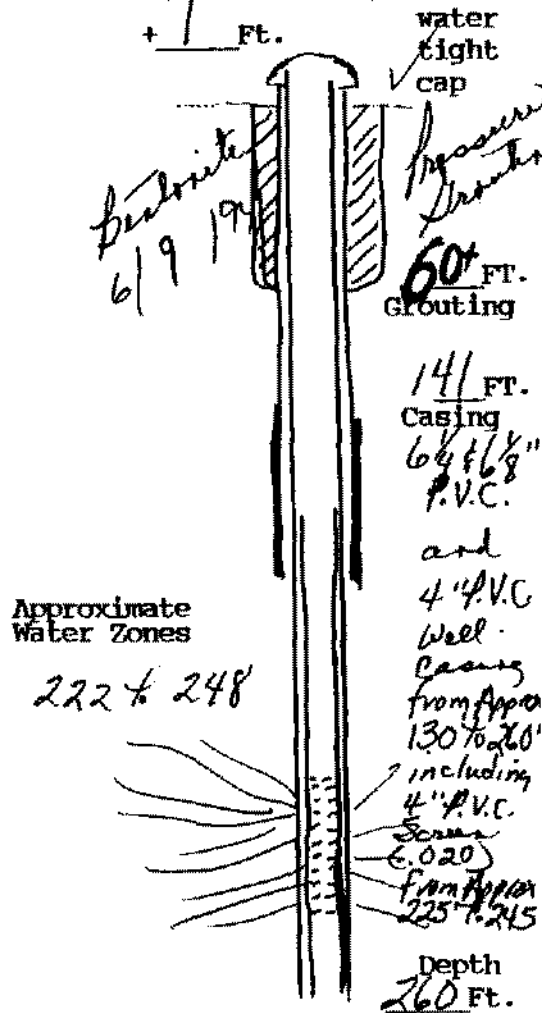

(User additional Sheets if necessary)

I certify that the information contained here is true and that this well was installed and constructed in accordance with the permit and further that the well complies with all applicable state and local regulations, ordinances and laws.

Name JOHN L. DANIELSON, JR., INC.  
 Address 4616 HOOD DRIVE  
FREDERICKSBURG, VIRGINIA 22408  
 Phone (703) 898-6025 / 898-9355

Drillers Signature John L. Danielson, Pres.  
 Date 4/9/94 Representing JOHN L. DANIELSON, JR., INC.

Virginia Contractors License Number CLASS A 2701 014084A II/H WVC