

**Commonwealth of Virginia  
Uniform Water Well Completion Report**

Owner Richard J. Dupre  
 Address 46 Main Street  
Stafford Va. 22554  
 Phone 770-26917?  
 Location Waldenmere Lot 15 - (Waldenmere Drive off 608)  
 Well Classification IIIA IIIB  IIIC IV  
 \* Well Data \*

Tax Map ID 40 A-15  
 VDH Permit WS-93-68  
 VWCB Permit \_\_\_\_\_  
 VWCB ID \_\_\_\_\_  
 County Stafford  
2/21/93 Donald J. Gault  
2/22/93 T.T. Thompson

**General Information**

Drilling Method Air Rotary Date Completed 5/6/93 Total Depth of Well 200'  
 Depth to Bedrock \_\_\_\_\_ Yield 600 (GPM) Length of Test 3 Hrs.  
 Static Water Level 60 Stabilized Water Level 100 Natural Flow (Rate) \_\_\_\_\_  
 Well Disinfected (Y or N) \_\_\_\_\_ Disinfectant Used \_\_\_\_\_ Amount Used \_\_\_\_\_

**Casing**

From 4 1/2" To 170 From 190 To 200 From \_\_\_\_\_ To \_\_\_\_\_  
 Size 4 1/2" Material P.V.C. Size 4 1/2" Material P.V.C. Size \_\_\_\_\_ Material \_\_\_\_\_  
 Weight/Schedule SDR 17 Weight/Schedule SDR 17 Weight/Schedule \_\_\_\_\_

**Gravel Pack**

From 90 To 200 From \_\_\_\_\_ To \_\_\_\_\_ From \_\_\_\_\_ To \_\_\_\_\_

**Hole size**

7 7/8" from 0 to 200 ft. \_\_\_\_\_ " from \_\_\_\_\_ to \_\_\_\_\_ ft. \_\_\_\_\_ " from \_\_\_\_\_ to \_\_\_\_\_ ft.

**Grout**

From 0 To 90' Ff From \_\_\_\_\_ To \_\_\_\_\_ From \_\_\_\_\_ To \_\_\_\_\_  
 Bore Hole Size 7 7/8" Bore Hole Size \_\_\_\_\_ Bore Hole Size \_\_\_\_\_  
 Type Dentonite Type \_\_\_\_\_ Type \_\_\_\_\_  
 Method Pressure Grouting Method \_\_\_\_\_ Method \_\_\_\_\_

**Water Zones or Screened Intervals**

From _____ To _____	From _____ To _____	From _____ To _____
Mesh Size _____ Diam _____	Mesh Size _____ Diam _____	Mesh Size _____ Diam _____
From _____ To _____	From _____ To _____	From _____ To _____
Mesh Size _____ Diam _____	Mesh Size _____ Diam _____	Mesh Size _____ Diam _____

\* Use Data \*

Private Well: Domestic  Agricultural \_\_\_\_\_ Industrial \_\_\_\_\_ Monitoring \_\_\_\_\_  
 Public Well: Community \_\_\_\_\_ Non Community \_\_\_\_\_

\* Abandonment Information \*

**Bored or Dug Wells**

Casing Removed, Y or N? \_\_\_\_\_  
 If Y, Depth to which casing was removed: \_\_\_\_\_  
 Depth and Type of Fill: \_\_\_\_\_  
 Source of Fill \_\_\_\_\_  
 Bentonite Plugs: From \_\_\_\_\_ to \_\_\_\_\_ From \_\_\_\_\_ to \_\_\_\_\_

**Wells other than Bored Wells**

Casing removed, Y or N? \_\_\_\_\_  
 Depth to which casing was removed: \_\_\_\_\_  
 Applicable, depth(s), and type of gravel/sand fill: \_\_\_\_\_  
 Source of gravel or sand: \_\_\_\_\_  
 Cement: From \_\_\_\_\_ to \_\_\_\_\_ From \_\_\_\_\_ to \_\_\_\_\_

Method of permanently marking location: \_\_\_\_\_

Installed watertight top  
 Suggest setting pump @ approx. 120 ft.  
Well pumped 20 G.P.M. @ 120' on 5/6/93


Key Log - New Century  
Richard Payne

Widernere #15  
Widernere Drive off #608  
 • Drillers Log •

Depth	Description of Formation or Sediment
0	2 Topsoil
2	20 Sandy Red Clay
20	120 Black Sand & Clay
120	140 Sandy Grey Clay
140	172 Brown Clay
172	193 White Sand (Water zone)
193	200 Brown Clay

Remarks (4 1/2" Well)

DIAGRAM (NOT TO SCALE)

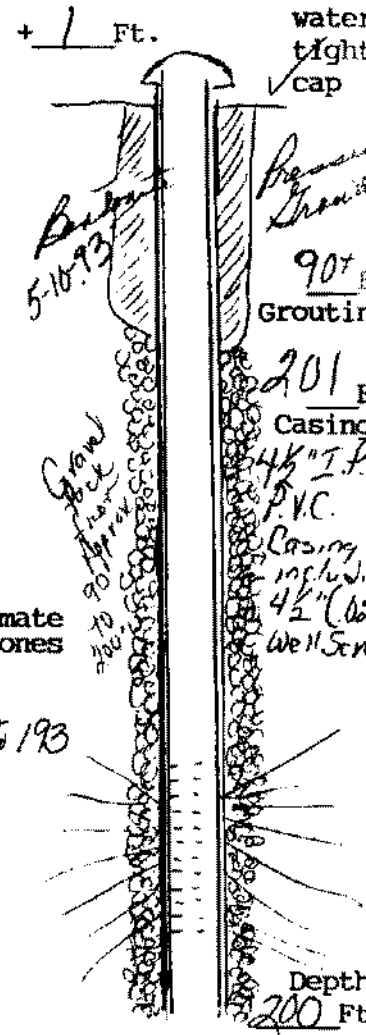

(User additional Sheets if necessary)

I certify that the information contained here is true and that this well was installed and constructed in accordance with the permit and further that the well complies with all applicable state and local regulations, ordinances and laws.

Name JOHN L. DANIELSON, JR., INC.  
 Address 4616 HOOD DRIVE  
FREDERICKSBURG, VIRGINIA 22408  
 Phone (703) 898-6025 / 898-9355

Drillers Signature *John Danielson, Jr.*  
 Date 5/10/93 Representing JOHN L. DANIELSON, JR., INC.

Virginia Contractors License Number CLASS A 2701 014084A H/H WWC