

Commonwealth of Virginia  
Uniform Water Well Completion Report

Owner Maily Massie  
 Address 629 Surprise View Lane  
Stafford VA  
 Phone (703) 659-7382  
 Location End of Rte. 666 on right  
 Well Classification IIIA IIIB  IIIC IV

Tax Map ID 40-44B  
 VMI Permit 105-94-27  
 VWCB Permit \_\_\_\_\_  
 VWCB ID \_\_\_\_\_  
 County Stafford

\* Well Data \*

General Information

Drilling Method Rotary Date Completed 8-5-94 Total Depth of Well 160 FT.  
 Depth to Bedrock \_\_\_\_\_ Yield 10 (GPM) Length of Test 4 hrs.  
 Static Water Level \_\_\_\_\_ Stblzd Water Level \_\_\_\_\_ Natural Flow (rate) \_\_\_\_\_  
 Well Disinfected (Y/N) Y Disinfectant Used Chlorine Amount Used 50 PPM

Casing

From <u>11</u> to <u>140</u>	From <u>135</u> to <u>145</u>	From _____ to _____
Size <u>1 1/2"</u> Material <u>PVC</u>	Size <u>2"</u> Material <u>Galv.</u>	Size _____ Material _____
Weight/Schedule <u>40</u>	Weight/Schedule <u>40</u>	Weight/Schedule _____

Gravel Pack

From \_\_\_\_\_ to \_\_\_\_\_ From \_\_\_\_\_ to \_\_\_\_\_ From \_\_\_\_\_ to \_\_\_\_\_

Grout

From <u>0</u> to <u>50</u>	From <u>50</u> to <u>140</u>	From <u>140</u> to <u>160</u>
Bore Hole Size <u>8"</u>	Bore Hole Size <u>7"</u>	Bore Hole Size <u>5 7/8"</u>
Type <u>Benseal</u>	Type _____	Type _____
Method <u>Pressure</u>	Method _____	Method _____

Water Zones or Screened Intervals

From <u>145</u> to <u>160</u>	From _____ to _____	From _____ to _____
Mesh Size <u>10</u> Diam. <u>2"</u>	Mesh Size _____ Diam. _____	Mesh Size _____ Diam. _____
From _____ to _____	From _____ to _____	From _____ to _____
Mesh Size _____ Diam. _____	Mesh Size _____ Diam. _____	Mesh Size _____ Diam. _____

\* Use Data \*

Private Well: Domestic  Agricultural \_\_\_\_\_ Industrial \_\_\_\_\_ Monitoring \_\_\_\_\_  
 Public Well: Community \_\_\_\_\_ Non Community \_\_\_\_\_

\* Abandonment Information \*

Bored or Dug Wells

Casing Removed, Y or N?: \_\_\_\_\_  
 If Y, Depth Removed: \_\_\_\_\_  
 Depth and Type of Fill: \_\_\_\_\_  
 Source of Fill: \_\_\_\_\_  
 Bentonite Plugs: From \_\_\_\_\_ to \_\_\_\_\_  
 From \_\_\_\_\_ to \_\_\_\_\_


Wells other than Bored Wells

Casing Removed, Y or N?: \_\_\_\_\_  
 If Y, Depth Removed: \_\_\_\_\_  
 Depth and type of Fill: \_\_\_\_\_  
 Source of Gravel or Sand: \_\_\_\_\_  
 Cement: From \_\_\_\_\_ to \_\_\_\_\_  
 From \_\_\_\_\_ to \_\_\_\_\_

Method of permanently marking location: \_\_\_\_\_

\*DRILLERS LOG\*

DEPTH	DESCRIPTION OF FORMATION OR SEDIMENT
0 - 60	Sand & gravel
60 - 90	Green clay
90 - 100	Blue sand
100 - 110	Blue clay
110 - 130	Pasty sand
130 - 160	Blue & white sand

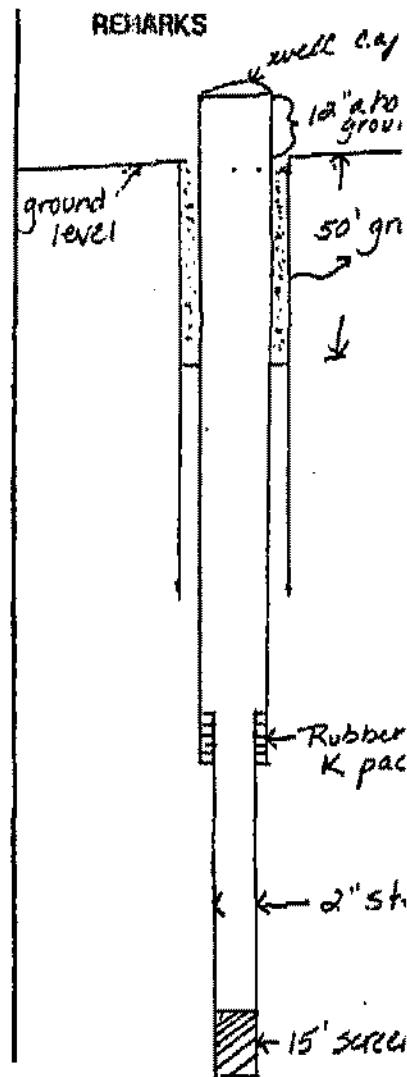

I certify that the information contained here is true and that this well was installed and constructed in accordance with the permit and further that the well complies with all applicable state and local regulations, ordinances and laws.

Name King George Drilling  
 Address FRL 1 - Box 86K,  
Colonial Beach, VA 22443  
 Phone 1804/ 224-9130

Driller's Signature *Joseph Jordan - Shepherd*  
 Date 8-5-94 representing Kenneth M. Frank, Jr.

Virginia Contractors License Number 023065 A