

**Commonwealth of Virginia
Uniform Water Well Completion Report**

Owner James Frazer
 Address 389 Widewater Road
Stafford, Va. 22554
 Phone 720-17067
 Location #608 - just WST Intersection with #621 - on left

Tax Map ID 41-16A-2
 VDH Permit SWP-95-77
 VWCB Permit _____
 VWCB ID _____
 County Stafford
3/16/96 Dan Jones
SFF

Well Classification IIIA _____ IIIB IIIC _____ IV _____
 * Well Data *

General Information

Drilling Method Air Rotary Date Completed 12/24/96
 Depth to Bedrock _____ Yield 25 (GPM)
 Static Water Level 40 Stabilized Water Level 80
 Well Disinfected (Y or N) _____ Disinfectant Used _____

Total Depth of Well 200
 Length of Test approx 1 Hr.
 Natural Flow (Rate) _____
 Amount Used _____

Casing

From 1 To 99 From 93 To 180
 Size 6 1/4 Material P.V.C. Size 4 Material P.V.C.
 Weight/Schedule SDR 27 Weight/Schedule Sch 40

From _____ To _____
 Size _____ Material _____
 Weight/Schedule _____

Gravel Pack

From _____ To _____ From _____ To _____
 Hole size 10" From 0 to 55ft. 7 7/8" From 55 to 99ft.

From _____ To _____
 Hole size 6 7/8" From 99 to 200ft.

Grout From 0 To 50+
 Bore Hole Size 10"
 Type Bentonite
 Method Pressure Grouting

From _____ To _____ From _____ To _____
 Bore Hole Size _____ Bore Hole Size _____
 Type _____ Type _____
 Method _____ Method _____

Water Zones or Screened Intervals

From 180 To 200
 Mesh Size .020 Diam 7" (P.V.C.)
 From _____ To _____
 Mesh Size _____ Diam _____

approx water zone
 From 182' To 192'
 Mesh Size _____ Diam _____
 From _____ To _____
 Mesh Size _____ Diam _____

*** Use Data ***

Private Well: Domestic Agricultural _____ Industrial _____ Monitoring _____
 Public Well: Community _____ Non Community _____

*** Abandonment Information ***

Bored or Dug Wells

Casing Removed, Y or N? _____
 If Y, Depth to which casing was removed: _____
 Depth and Type of Fill: _____
 Source of Fill _____
 Bentonite Plugs: From _____ to _____ From _____ to _____

Wells other than Bored Wells

Casing removed, Y or N? _____
 Depth to which casing was removed: _____
 Applicable, depth(s), and type of gravel/sand fill: _____
 Source of gravel or sand: _____
 Cement: From _____ to _____ From _____ to _____

Method of permanently marking location:


Installed watertight top
 Suggest setting pump @ approx. 100 ft. Well pumped 15 G.P.M. @ 100ft on 12/24/96
you will encounter 4" casing @ approx 95 ft.
Suggest keeping centralizers & torque arrestors out of 4" casing.

608 - on left - just past intersection with 621

Stafford

* Drillers Log *

Depth	Description of Formation or Sediment	Remarks
0	10	Sandy Red Clay
10	30	yellow sand
30	50	Blue Mare
50	90	Black Sand
90	182	Blue Clay
182	192	Grey Sand - Water zone
192	200	Brown Clay

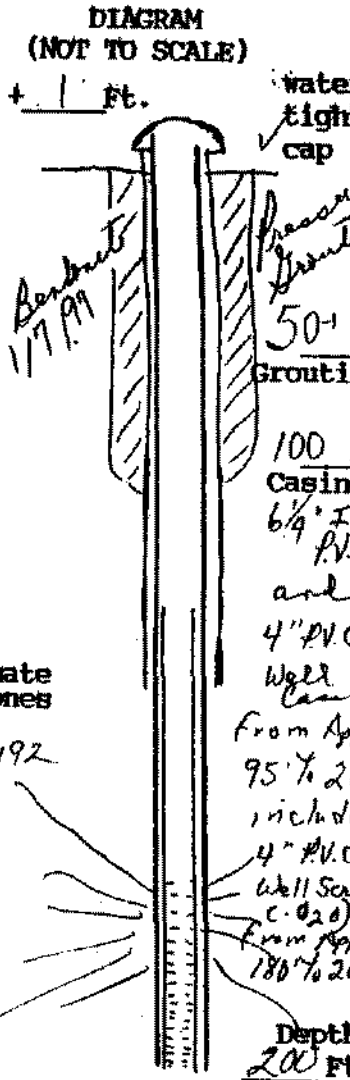

Approximate Water Zones
182 to 192

(User additional Sheets if necessary)

I certify that the information contained here is true and that this well was installed and constructed in accordance with the permit and further that the well complies with all applicable state and local regulations, ordinances and laws.

Name JOHN L. DANIELSON, JR., INC.
 Address 4516 HOOD DRIVE
FREDERICKSBURG, VIRGINIA 22408
 Phone 540 (202) 898-6025 / 898-9355

Drillers Signature [Signature]
 Date 7/7/97 Representing JOHN L. DANIELSON, JR., INC.

Virginia Contractors License Number CLASS A 2701 014084A H/H WWC