

Commonwealth of Virginia
Uniform Water Well Completion Report

41-4P

County Stafford
City/Town Stafford
Address 18 Quarry Road
Stafford, Va.
Phone 659-7717
Location Widewater #658 (Approx 1/4 M. N. of E. End of 658 on left)
Well Classification IIIA IIIB IIIC IV

Tax Map ID 41-4P
VDH Permit SWP-95-80
VWCB Permit _____
VWCB ID _____
County STAFFORD
3/21/95 Ratton B. Wright
DGI

General Information

Drilling Method Mud Rotary Date Completed 10/9/95 Total Depth of Well 230'
Depth to Bedrock _____ Yield 60 (GPM) Length of Test approx 2 hrs
Static Water Level approx 20 Stabilized Water Level _____ Natural Flow (Rate) _____
Well Disinfected (Y or N) _____ Disinfectant Used _____ Amount Used _____

Casing

From 7 1/2 To 210 From _____ To _____
Size 4 1/2 Material P.V.C. Size _____ Material _____
Weight/Schedule SDR 17 Weight/Schedule _____ Weight/Schedule _____

Gravel Pack Bags #2 Well Gravel

From 50 To 230 From _____ To _____

Hole size

7 1/8 from 0 to 230 ft. _____ " from _____ to _____ ft.

Grout From 0 To 50+ From _____ To _____
Bore Hole Size 7 1/8 Bore Hole Size _____
Type Bentonite Type _____
Method Pressure Grouting Method _____

Water Zones or Screened Intervals

From 210 To 230 From approx water zone 205 To 229 From _____ To _____
Mesh Size .020 Diam 4 1/2" (P.V.C.) Mesh Size _____ Diam _____ Mesh Size _____ Diam _____
From _____ To _____ From _____ To _____ From _____ To _____
Mesh Size _____ Diam _____ Mesh Size _____ Diam _____ Mesh Size _____ Diam _____

* Use Data *

Private Well: Domestic Agricultural _____ Industrial _____ Monitoring _____
Public Well: Community _____ Non Community _____

* Abandonment Information *

Bored or Dug Wells

Casing Removed, Y or N?: _____
If Y, Depth to which casing was removed: _____
Depth and Type of Fill: _____
Source of Fill _____
Bentonite Plugs: From _____ to _____ From _____ to _____

Wells other than Bored Wells


Casing removed, Y or N?: _____
Depth to which casing was removed: _____
Applicable, depth(s), and type of gravel/sand fill: _____
Source of gravel or sand: _____
Cement: From _____ to _____ From _____ to _____

Method of permanently marking location: _____
 Installed watertight top
Suggest setting pump @ approx. _____ ft.

American Family Homes
Jane Landenslager
Ellen Brook Est
Widewater #658
Stafford

* Drillers Log *

Depth	Description of Formation or Sediment	Remarks
0	10	Red Sandy Clay
10	30	Blue Marl
30	80	Sandy Grey Clay
80	110	Brown Clay
110	130	Grey Clay
130	145	Grey Sand
145	205	Grey Sandy Clay
205	229	Grey Sand
229	230	Grey Clay

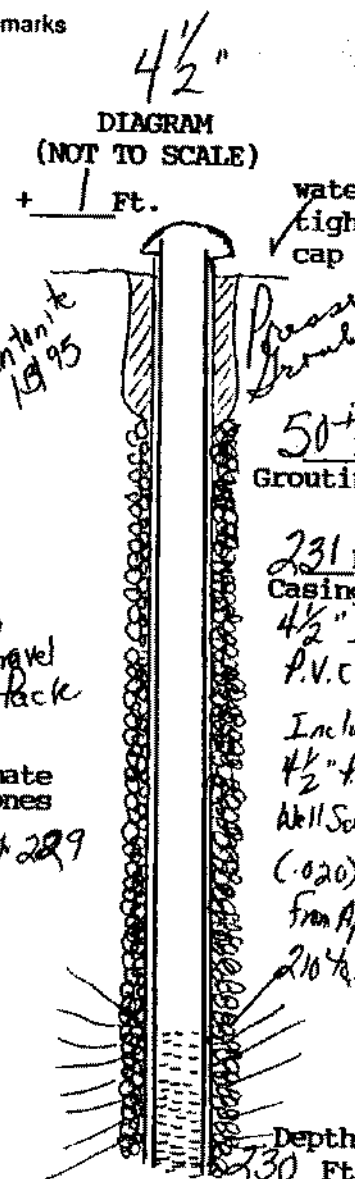

(User additional Sheets if necessary)

I certify that the information contained here is true and that this well was installed and constructed in accordance with the permit and further that the well complies with all applicable state and local regulations, ordinances and laws.

Name JOHN L. DANIELSON, JR., INC.
 Address 4616 HOOD DRIVE
FREDERICKSBURG, VIRGINIA 22408
 Phone (703) 898-6025 / 898-9355

Drillers Signature *John L. Danielson, Jr.*
 Date 10/13/95 Representing JOHN L. DANIELSON, JR., INC.

Virginia Contractors License Number CLASS A 2701 014084A H/H WVC