

Commonwealth of Virginia

Uniform Water Well Completion Report

Owner Mary Lou Weselby
Address 120A Shirley Colward Street
Fredenburgh, Va. 22401
Phone 373-2176
Location Castlebury Estates # 5A

Tax Map ID 41C-5
VDH Permit SWP-96-349
VWCB Permit _____
VWCB ID _____
County Stafford
10/9/96 Daniel J. Gessly
SFF

Well Classification IIIA _____ IIIB IIIC _____ IV _____
* Well Data *

General Information
Drilling Method Air Rotary
Depth to Bedrock _____
Static Water Level 100
Well Disinfected (Y or N) _____

Date Completed 1/30/97
Yield 20 (GPM)
Stabilized Water Level 180
Disinfectant Used _____

Total Depth of Well 250'
Length of Test approx 1 Hr.
Natural Flow (Rate) _____
Amount Used _____

Casing
From +1 To 76
Size 4" Material P.V.C.
Weight/Schedule S.D.R. 27

From 70 To 230
Size 4" Material P.V.C.
Weight/Schedule Sch 40

From _____ To _____
Size _____ Material _____
Weight/Schedule _____

Gravel Pack
From _____ To _____

From _____ To _____

From _____ To _____

Hole size
10" from 0 to 60 ft.

7 7/8" from 60 to 75 ft.

6 1/2" from 75 to 250 ft.

Grout
From 0 To 50'
Bore Hole Size 10" 2/6/97
Type Bestonite
Method Pressure Grouting

From _____ To _____
Bore Hole Size _____
Type _____
Method _____

From _____ To _____
Bore Hole Size _____
Type _____
Method _____

Water Zones or Screened Intervals

From 230' To 250'
Mesh Size 0/16 Diam 4" (P.V.C.)
From _____ To _____
Mesh Size _____ Diam _____

From 230 To 245
Mesh Size _____ Diam _____
From _____ To _____
Mesh Size _____ Diam _____

From _____ To _____
Mesh Size _____ Diam _____
From _____ To _____
Mesh Size _____ Diam _____

* Use Data *

Private Well: Domestic Agricultural _____ Industrial _____ Monitoring _____
Public Well: Community _____ Non Community _____

* Abandonment Information *

Bored or Dug Wells
Casing Removed, Y or N?: _____
If Y, Depth to which casing was removed: _____
Depth and Type of Fill: _____
Source of Fill _____
Bentonite Plugs: From _____ to _____ From _____ to _____

Wells other than Bored Wells
Casing removed, Y or N? _____
Depth to which casing was removed: _____
Applicable, depth(s), and type of gravel/sand fill: _____
Source of gravel or sand: _____
Cement: From _____ to _____ From _____ to _____

Method of permanently marking location: _____

Installed watertight top
Suggest setting pump @ approx 200 ft.


You will encounter 4" casing @ approx 70 ft.
Suggest keeping centralizer & torque arresters out of 4" casing

Dallas Barnes
 Mary Lou Weselin
 Canterbury Estates # 5A
 Stafford
 Brook Rd. - 608 - Marlborough Court
 Drillers Log

8118
 J. H. HARRIS
 181 York St.
 P.O. Box 100
 Old Greenwich, CT 06870

Depth Description of Formation or Sediment Remarks

0	10	Sandy Red Clay
10	30	Yellow Sand
30	85	Blue Marl
85	140	Black Sand
140	230	Blue Clay
230	245	Grey Sand - water zone
245	250	Brown clay

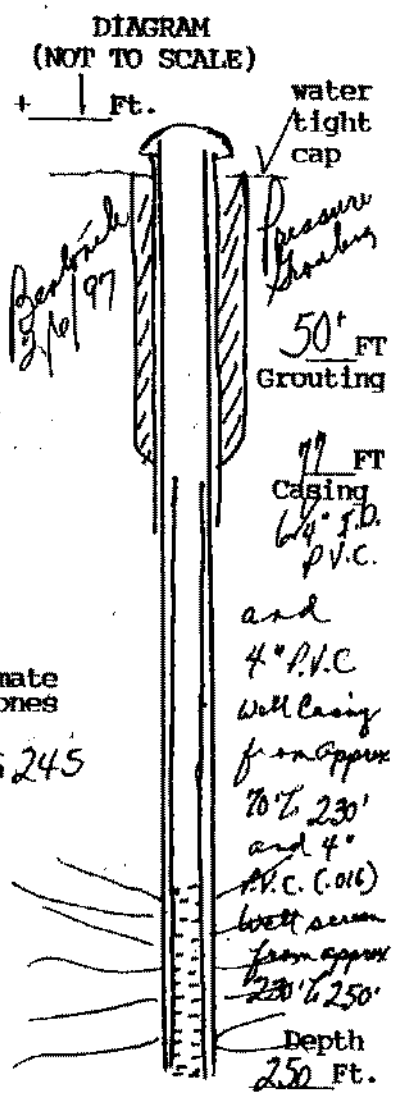

Approximate Water Zones
 230 to 245

(User additional Sheets if necessary)

I certify that the information contained here is true and that this well was installed and constructed in accordance with the permit and further that the well complies with all applicable state and local regulations, ordinances and laws.

Name JOHN L. DANIELSON, JR., INC.
 Address 4616 HOOD DRIVE
FREDERICKSBURG, VIRGINIA 22408
 Phone 540 (703) 898-6025 / 898-9355

Drillers Signature John L. Danielson, Jr.
 Date 2/16/97 Representing JOHN L. DANIELSON, JR., INC.

Virginia Contractors License Number CLASS A 2701 014084A II/II WVC