

Sejan
 Builders Inc.
 39617 Jefferson Davis Highway
 Manassas, Va 22556
 703-221-2259 F 221-2679

Commonwealth of Virginia
 Uniform Water Well Completion Report

Owner Ivan Jones
 Address 1 Seabrook Court
Stafford, Va 22554
 Phone (659) 461-83
 Location Brookes Ridge #1 off 608

Tax Map ID 41D-1
 VDH Permit SWP-97-240 SWP-97-246
 VWCB Permit _____
 VWCB ID _____
 County Stafford
7/1/97 At Snyder
SFF

Well Classification TTA TTD TTE TTV
 * Well Data *

General Information
 Drilling Method Air Mud Rotary
 Depth to Bedrock _____
 Static Water Level 92'
 Well Disinfected (Y or N) _____

Date Completed 11/25/97
 Yield 25 (GPM)
 Stabilized Water Level 10'
 Disinfectant Used _____

Total Depth of Well 180'
 Length of Test approx 1 hr.
 Natural Flow (Ft/d) _____
 Amount Used _____

Casing
 From 71 To 85
 Weight/Schedule S.O.R. 27

From 70 To 150
 Weight/Schedule Sch. 40

From 150 To 180
 Weight/Schedule Sch. 40

Gravel Pack
 From 0 To 50'
 Bore Hole Size 10"
 Type Ballast
 Method Pressure Drilling

From 70 To 150
 Bore Hole Size _____
 Type _____
 Method _____

From 150 To 180
 Bore Hole Size _____
 Type _____
 Method _____

Water Zones or Screened Intervals
 From 150 To 170
 Mesh Size #20 Diam 4" (P.V.C.)

approx water zone
 From 150 To 170
 Mesh Size _____ Diam _____

From _____ To _____
 Mesh Size _____ Diam _____

* Use Data *

Private Well: Domestic Agricultural _____ Industrial _____ Monitoring _____
 Public Well: Community _____ Non Community _____

* Abandonment Information *

Bored or Dug Wells
 Casing Removed, Y or N? _____
 If Y, Depth to which casing was removed: _____
 Depth and Type of Fill: _____
 Source of Fill: _____
 Bentonite Plugs: From _____ to _____ From _____ to _____


Wells other than Bored Wells
 Casing removed, Y or N? _____
 Depth to which casing was removed: _____
 Applicable, depth(s), and type of gravel/sand fill: _____
 Source of gravel or sand: _____
 Cement: From _____ to _____ From _____ to _____

Method of permanently marking location:
 Installed watertight top
 Suggest setting pump @ approx 100 ft.

Brook Builders
Ivan Flores
Brooke Ridge #1
Stafford
off #608

* Drillers Log *

Depth	Description of Formation or Sediment	Remarks
0	10	Red Clay
10	30	Yellow Sand
30	50	Sand & Gravel
50	85	Blue Clay
85	150	Red Clay
150	170	Grey Sand - water zone
170	180	Brown Clay

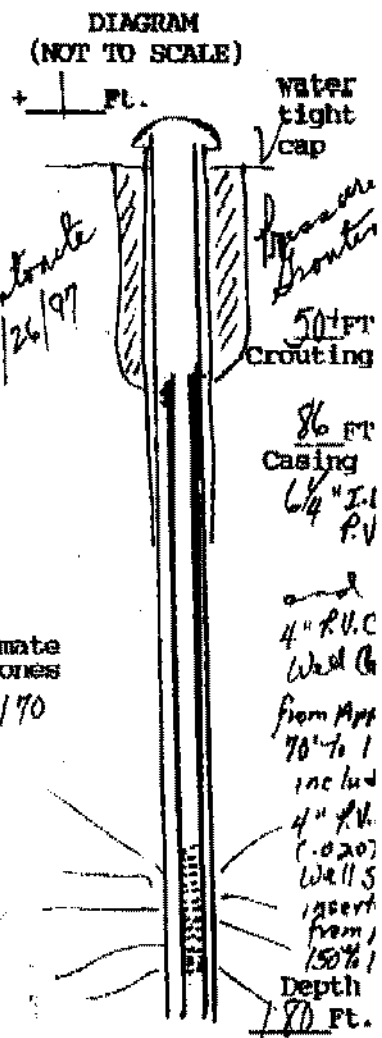

Approximate Water Zones
 150 to 170

(User additional Sheets if necessary)

I certify that the information contained here is true and that this well was installed and constructed in accordance with the permit and further that the well complies with all applicable state and local regulations, ordinances and laws.

Name JOHN L. DANIELSON, JR., INC.
 Address 4616 HOOD DRIVE
FREDERICKSBURG, VIRGINIA 22408
 Phone 570 (783) 090-6025 / 898-9355
 Drillers Signature [Signature]
 Date 11/24/97 Representing JOHN L. DANIELSON, JR., INC.
 Virginia Contractors License Number CLASS A 2701 014084A H/H WVC