

OFFICE OF ANIMAL HEALTH
REGULATORY

Seannise Homes, Inc
2 Falling Water Court
Fredericksburg VA 22405 Commonwealth of Virginia
Uniform Water Well Completion Report

371-0944 FAX 071-0872
Owner Seannise Homes / For Sale
Address 2 Falling Water Court,
Fredericksburg, Va. 22405
Phone 371-3944 / 1371-0944
Location Brooks Ridge #17 (18 Brook Crest Lane)

Tax Map ID 41D-17
VDH Permit SWP-97-393
VWCB Permit _____
VWCB ID _____
County STAFFORD
Rob Snyder
CXC

Well Classification IIIA IIIB _____ IIIC _____ IV _____
* Well Data *

General Information

Drilling Method Mud Rotary Date Completed 11/26/97 Total Depth of Well 268'
Depth to Bedrock _____ Yield 30 (GPM) Length of Test approx 4 HRS
Static Water Level 100' Stabilized Water Level 160' Natural Flow (Rate) _____
Well Disinfected (Y or N) _____ Disinfectant Used _____ Amount Used _____

Casing

From 1 To 228 From 248 To 268 From _____ To _____
Size 4 1/2" Material P.V.C. Size 4 1/2" Material P.V.C. Size _____ Material _____
Weight/Schedule S.D.R. 17 Weight/Schedule S.D.R. 17 Weight/Schedule _____

Gravel Pack

Size #2 - well Gravel
From 200 To 268 From _____ To _____ From _____ To _____

Hole size

7 7/8" from 0 to 268 ft. " from _____ to _____ ft. " from _____ to _____ ft.

Grout

From 0 To 22 1/2 From _____ To _____ From _____ To _____
Bore Hole Size 7 7/8 Bore Hole Size _____ Bore Hole Size _____
Type Bentonite Type _____ Type _____
Method Pressure Grouting Method _____ Method _____
MA - R.S. 12/3/97 (14 Bags Aqua Grout)

Water Zones or Screened Intervals

From 228 To 248 From _____ To _____ From _____ To _____
Mesh Size 20 Diam 4 1/2" (P.V.C.) Mesh Size _____ Diam _____ Mesh Size _____ Diam _____
From _____ To _____ From _____ To _____ From _____ To _____
Mesh Size _____ Diam _____ Mesh Size _____ Diam _____ Mesh Size _____ Diam _____

* Use Data *

Private Well: Domestic Agricultural _____ Industrial _____ Monitoring _____
Public Well: Community _____ Non Community _____

12/3
3/4 H.P. 10GPM
STA-Rite Submersible
(STAINLESS STEEL)
WX 250 Tank

* Abandonment Information *

Bored or Dug Wells

Casing Removed, Y or N? _____
If Y, Depth to which casing was removed: _____
Depth and Type of Fill: _____
Source of Fill _____
Bentonite Plugs: From _____ to _____ From _____ to _____

Wells other than Bored Wells

Casing removed, Y or N? _____
Depth to which casing was removed: _____
Applicable, depth(s), and type of gravel/sand fill: _____
Source of gravel or sand: _____
Cement: From _____ to _____ From _____ to _____

Method of permanently marking location: _____
 Installed watertight top
Suggest setting pump @ approx. 180 ft.


John Stafford
 Sunrise Homes
 Brooke Ridge #17
 Stafford
 off #608

* Drillers Log *

Department of Health
 F.H.A. or V.A. Case Number
 If Applicable

Depth	Description of Formation or Sediment	Remarks
0	10	Red Clay
10	60	Collapsing sand & gravel
60	80	grey sandy clay
80	180	Black Sand
180	220	Sandy Grey clay
220	248	Grey Sand - water zone
248	268	Grey clay

DIAGRAM (NOT TO SCALE)

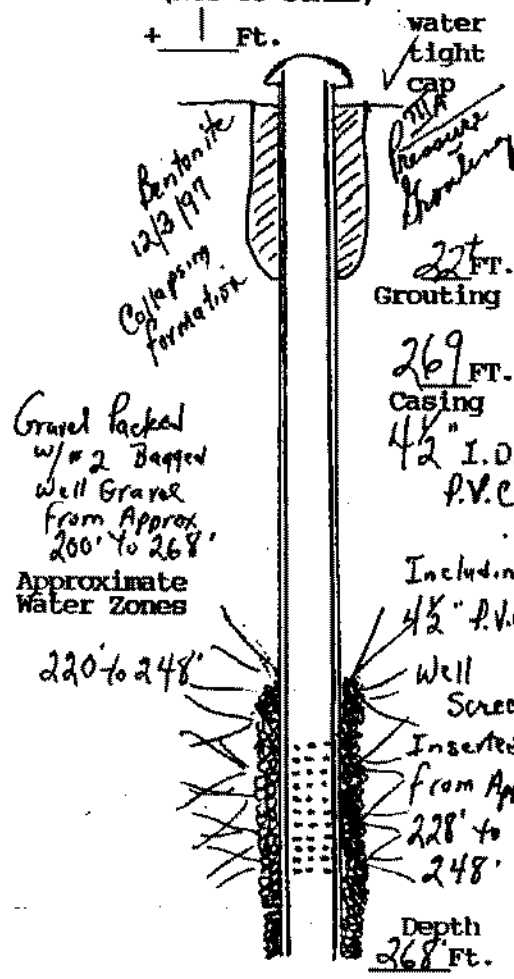

(User additional Sheets if necessary)

I certify that the information contained here is true and that this well was installed and constructed in accordance with the permit and further that the well complies with all applicable state and local regulations, ordinances and laws.

Name JOHN L. DANIELSON, JR., INC.
 Address 4616 HOOD DRIVE
FREDERICKSBURG, VIRGINIA 22408
 Phone 540 (703) 898-6025 / 898-9355

Drillers Signature John L. Danielson, Pres.
 Date 2/3/97 Representing JOHN L. DANIELSON, JR., INC.

Virginia Contractors License Number CLASS A 2701 014084A H/H WVC