

Arbuckle Home  
Box 1687  
Stafford, VA 22555  
7720-5751

Commonwealth of Virginia  
Uniform Water Well Completion Report

Owner Arbuckle Home / For Sale  
Address Box 1687  
Stafford, VA 22555  
Phone 7720-5751  
Location Brookridge # 8 - off 608

Tax Map ID 41D-8  
VDH Permit SWP-98-01  
VWCB Permit \_\_\_\_\_  
VWCB ID \_\_\_\_\_  
County Stafford  
1/7/98 Andrew B. Wang  
C.R.B.

Well Classification IIIA \_\_\_\_\_ IIIB  IIIC \_\_\_\_\_ IV \_\_\_\_\_  
\* Well Data \*

General Information  
Drilling Method Mod Rotary Date Completed 7/10/98 Total Depth of Well 347'  
Depth to Bedrock \_\_\_\_\_ Yield 60 (GPM) Length of Test approx 2 hrs  
Static Water Level 260' Stabilized Water Level 240' Natural Flow (Rate) \_\_\_\_\_  
Well Disinfected (Y or N) \_\_\_\_\_ Disinfectant Used \_\_\_\_\_ Amount Used \_\_\_\_\_

Casing  
From +1 To 320 From 340' To 347' From \_\_\_\_\_ To \_\_\_\_\_  
Size 4 1/2" Material PVC Size 4 1/2" Material PVC Size \_\_\_\_\_ Material \_\_\_\_\_  
Weight/Schedule SDR 17 Weight/Schedule SDR 17 Weight/Schedule \_\_\_\_\_

Gravel Pack  
From 50 To 347 From \_\_\_\_\_ To \_\_\_\_\_ From \_\_\_\_\_ To \_\_\_\_\_  
Hole size 7/8" from 0 to 347 ft. " from \_\_\_\_\_ to \_\_\_\_\_ ft.  
Grout  
From 0 To 50+ From \_\_\_\_\_ To \_\_\_\_\_ From \_\_\_\_\_ To \_\_\_\_\_  
Bore Hole Size 7/8" Bore Hole Size \_\_\_\_\_ Bore Hole Size \_\_\_\_\_  
Type Bentonite Type \_\_\_\_\_ Type \_\_\_\_\_  
Method Pressure Fracture Method \_\_\_\_\_ Method \_\_\_\_\_

Water Zones or Screened Intervals  
From 320 To 340 From \_\_\_\_\_ To \_\_\_\_\_ From \_\_\_\_\_ To \_\_\_\_\_  
Mesh Size 20 Diam 4 1/2" (PVC) Mesh Size \_\_\_\_\_ Diam \_\_\_\_\_ Mesh Size \_\_\_\_\_ Diam \_\_\_\_\_  
From \_\_\_\_\_ To \_\_\_\_\_ From \_\_\_\_\_ To \_\_\_\_\_ From \_\_\_\_\_ To \_\_\_\_\_  
Mesh Size \_\_\_\_\_ Diam \_\_\_\_\_ Mesh Size \_\_\_\_\_ Diam \_\_\_\_\_ Mesh Size \_\_\_\_\_ Diam \_\_\_\_\_

\* Use Data \*

Private Well: Domestic  Agricultural \_\_\_\_\_ Industrial \_\_\_\_\_ Monitoring \_\_\_\_\_  
Public Well: Community \_\_\_\_\_ Non Community \_\_\_\_\_

3/4 H.P. 10 GPM STA. Rate  
STA. W/LESS TEST  
5-boring-bit  
WX 250 Tank

\* Abandonment Information \*

Bored or Dug Wells  
Casing Removed, Y or N? \_\_\_\_\_  
If Y, Depth to which casing was removed: \_\_\_\_\_  
Depth and Type of Fill: \_\_\_\_\_  
Source of Fill: \_\_\_\_\_  
Bentonite Plugs: From \_\_\_\_\_ to \_\_\_\_\_ From \_\_\_\_\_ to \_\_\_\_\_

Wells other than Bored Wells  
Casing removed, Y or N? \_\_\_\_\_  
Depth to which casing was removed: \_\_\_\_\_  
Applicable, depth(s), and type of gravel/sand fill: \_\_\_\_\_  
Source of gravel or sand: \_\_\_\_\_  
Cement: From \_\_\_\_\_ to \_\_\_\_\_ From \_\_\_\_\_ to \_\_\_\_\_

Method of permanently marking location: \_\_\_\_\_  
Installed watertight top  
Flagged nothing else in ground 760 ft


Adage #8  
 Sheppard  
 071 604

Drillers Log

Description of Formation or Sediment

Remarks

0	10	Red Clay
10	50	Green Sand
50	270	Black Sand & Shells
270	290	Red Clay
290	300	Grey Clay
300	320	Sandy Grey Clay
320	540	Grey Sand
540	940	Grey Clay

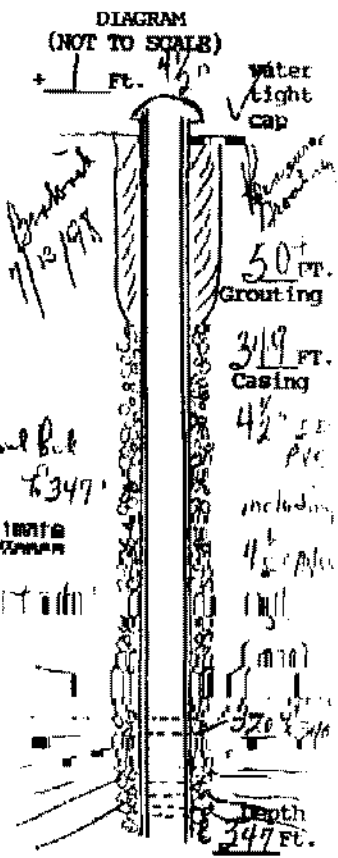

(Use additional Sheets if necessary)

I hereby certify that the information contained herein is true and correct to the best of my knowledge and belief.

\_\_\_\_\_  
 JOHN L. [unclear], DRILLER

\_\_\_\_\_  
 [unclear]

\_\_\_\_\_  
 [unclear]