

Commonwealth of Virginia  
Uniform Water Well Completion Report

John Thomas  
Cable Builders, Inc.  
P.O. Box 2291  
Stafford Va 22559  
659-0588 Fax 659-0580

Owner Cable Builders Christopher Lavigne  
Address P.O. Box 2291  
Stafford Va 22555  
Phone 659-0588  
Location Brooke Ridge - Lot 20 / 3/4 Brooke Crest Lane

Tax Map ID 4D-20  
VOH Permit W-02-414  
VWCB Permit \_\_\_\_\_  
VWCB ID \_\_\_\_\_  
County Stafford  
8/3/02 Ret. Sanyam  
MK

Well Classification IIIA \_\_\_\_\_ IIIB  IIIC \_\_\_\_\_ IV \_\_\_\_\_  
\* Well Data \*

General Information  
Drilling Method Mud Rotary  
Depth to bedrock  
Static Water Level 20'  
Well Detected (Y or N) \_\_\_\_\_

Date Completed 9/10/02  
Yield 30 (GPM)  
Stabilized Water Level 170  
Disinfectant Used \_\_\_\_\_

Total Depth of Well 310'  
Length of Test Approx. 1 Hr.  
Natural Flow (Rate) \_\_\_\_\_  
Amount Used \_\_\_\_\_

Casing  
From 1' To 290  
Size 4 1/2" Material PVC  
Weight/Schedule SDR 17

From 290 To 310  
Size 4 1/2" Material PVC  
Weight/Schedule SDR 17

From \_\_\_\_\_ To \_\_\_\_\_  
Size \_\_\_\_\_ Material \_\_\_\_\_  
Weight/Schedule \_\_\_\_\_

Gravel Patch  
From 50 To 310

From \_\_\_\_\_ To \_\_\_\_\_

From \_\_\_\_\_ To \_\_\_\_\_

Gravel size  
1/2" from 0 to 310ft.

" from \_\_\_\_\_ to \_\_\_\_\_ ft.

" from \_\_\_\_\_ to \_\_\_\_\_ ft.

From 0 To 50'  
Bore Hole Size 7 1/2" 9/14/02  
Type Rotary  
Method Rotary Drilling

From \_\_\_\_\_ To \_\_\_\_\_  
Bore Hole Size \_\_\_\_\_  
Type \_\_\_\_\_  
Method \_\_\_\_\_

From \_\_\_\_\_ To \_\_\_\_\_  
Bore Hole Size \_\_\_\_\_  
Type \_\_\_\_\_  
Method \_\_\_\_\_

Water Zones or Screened Intervals

From 280 To 290  
Mesh Size 20 Diam 4 1/2" (P.V.C.)  
From \_\_\_\_\_ To \_\_\_\_\_  
Mesh Size \_\_\_\_\_ Diam \_\_\_\_\_

From \_\_\_\_\_ To \_\_\_\_\_  
Mesh Size \_\_\_\_\_ Diam \_\_\_\_\_  
\* Use Data \*

Private Well: Domestic  Agricultural \_\_\_\_\_ Industrial \_\_\_\_\_ Monitoring \_\_\_\_\_  
Public Well: Community \_\_\_\_\_ Non Community \_\_\_\_\_

\* Abandonment Information \*

Bored or Dug Wells  
Casing Removed, Y or N? \_\_\_\_\_  
If Y, Depth to which casing was removed: \_\_\_\_\_  
Depth and Type of Fill: \_\_\_\_\_  
Source of Fill \_\_\_\_\_  
Bentonite Plugs: From \_\_\_\_\_ to \_\_\_\_\_ From \_\_\_\_\_ to \_\_\_\_\_

Wells other than Bored Wells  
Casing removed, Y or N? \_\_\_\_\_  
Depth to which casing was removed: \_\_\_\_\_  
Applicable, depth(s), and type of gravel/sand fill: \_\_\_\_\_  
Source of gravel or sand: \_\_\_\_\_  
Cement: From \_\_\_\_\_ to \_\_\_\_\_ From \_\_\_\_\_ to \_\_\_\_\_

Method of permanently marking location:  
Installed watertight top  
Suggest setting pump @ approx 200 ft.

223350


*Buildings*  
*Brooks Lodge #20*  
*Stafford*  
*36 Brooks Court Lane*

\* Drillers Log \*

Depth Description of Formation or Sediment Remarks

0	20	Sandy Brown clay
20	60	Sandy Grey clay
60	165	Black Sand & Shells
65	175	Grey clay
95	220	Sandy Grey clay
220	230	Brown clay
30	235	Sandy Grey clay
35	240	Sand
40	255	Sandy Grey clay
55	270	Green & Grey clay
70	290	Sand - water zone
90	310	Sandy Grey clay

DIAGRAM (NOT TO SCALE)

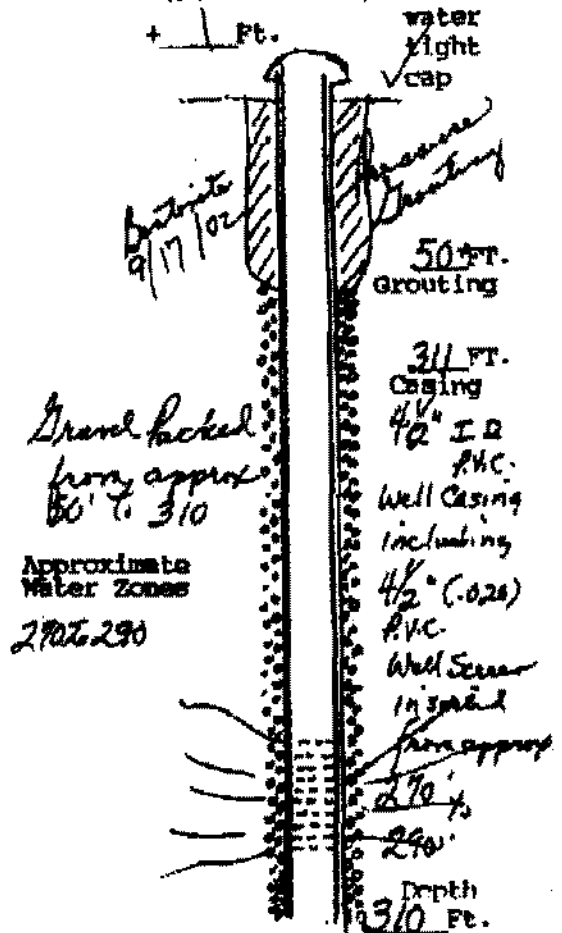

(Use additional sheets if necessary)

certify that the information contained here is true and that this well was installed and constructed in accordance with the permit and other that the well complies with all applicable state and local regulations, ordinances and laws.

name JOHN L. DANIELSON, JR., INC.  
 address 1616 HOOD DRIVE  
FREDERICKSBURG, VIRGINIA 22408  
 phone (803) 898-6025 / 898-9355

Drillers Signature *John L. Danielson, Jr.*  
 Date 9/17/02 Representing JOHN L. DANIELSON, JR., INC.

Virginia Contractors License Number CLASS A 2701 01408/1A 11/11 WNC