

**Commonwealth of Virginia  
Uniform Water Well Completion Report**

Owner William W. Rawlings  
 Address 19 Myrtle St.  
Stafford, Va. 22554  
 Phone 659-16401  
 Location Wildewater Beach Sect 2 Lots 401-402-403  
182A  
 Well Classification IIIA  IIIB  IIIC  IV   
 \* Well Data \*

Tax Map ID 41B-2-403  
 VDH Permit W-95-207  
 VWCB Permit \_\_\_\_\_  
 VWCB ID \_\_\_\_\_  
 County STAFFORD  
6/27/95 Daniel J. Searby  
SFF

**General Information**  
 Drilling Method Air Rotary  
 Depth to Bedrock \_\_\_\_\_  
 Static Water Level approx 10  
 Well Disinfected (Y or N) \_\_\_\_\_

Date Completed 7/10/95  
 Yield 60 (GPM)  
 Stabilized Water Level 25  
 Disinfectant Used \_\_\_\_\_

Total Depth of Well 120  
 Length of Test approx 1 Hr.  
 Natural Flow (Rate) \_\_\_\_\_  
 Amount Used \_\_\_\_\_

**Casing**  
 From 11 To 83  
 Size 6 1/4 Material P.V.C.  
 Weight/Schedule S.D.R. 207

From 80 To 100  
 Size 4" Material P.V.C.  
 Weight/Schedule Sch 40

From \_\_\_\_\_ To \_\_\_\_\_  
 Size \_\_\_\_\_ Material \_\_\_\_\_  
 Weight/Schedule \_\_\_\_\_

**Gravel Pack**  
 From \_\_\_\_\_ To \_\_\_\_\_  
**Hole size**  
10" from 0 to 50 ft.  
**Grout**  
 From 0 To 50+  
 Bore Hole Size 10"  
 Type Bentonite  
 Method Pressure Grouting

From \_\_\_\_\_ To \_\_\_\_\_  
 Hole size 7 7/8" from 50 to 83 ft.  
 From \_\_\_\_\_ To \_\_\_\_\_  
 Bore Hole Size \_\_\_\_\_  
 Type \_\_\_\_\_  
 Method \_\_\_\_\_

From \_\_\_\_\_ To \_\_\_\_\_  
 Hole size 6" from 83 to 120 ft.  
 From \_\_\_\_\_ To \_\_\_\_\_  
 Bore Hole Size \_\_\_\_\_  
 Type \_\_\_\_\_  
 Method \_\_\_\_\_

**Water Zones or Screened Intervals**  
 From 100 To 120  
 Mesh Size .020 Diam 9" P.V.C.  
 From \_\_\_\_\_ To \_\_\_\_\_  
 Mesh Size \_\_\_\_\_ Diam \_\_\_\_\_

approx water zone  
 From 100 To 117  
 Mesh Size \_\_\_\_\_ Diam \_\_\_\_\_  
 From \_\_\_\_\_ To \_\_\_\_\_  
 Mesh Size \_\_\_\_\_ Diam \_\_\_\_\_

From \_\_\_\_\_ To \_\_\_\_\_  
 Mesh Size \_\_\_\_\_ Diam \_\_\_\_\_  
 From \_\_\_\_\_ To \_\_\_\_\_  
 Mesh Size \_\_\_\_\_ Diam \_\_\_\_\_

\* Use Data \*

Private Well: Domestic  Agricultural \_\_\_\_\_ Industrial \_\_\_\_\_ Monitoring \_\_\_\_\_  
 Public Well: Community \_\_\_\_\_ Non Community \_\_\_\_\_

\* Abandonment Information \*

**Bored or Dug Wells**  
 Casing Removed, Y or N?: \_\_\_\_\_  
 If Y, Depth to which casing was removed: \_\_\_\_\_  
 Depth and Type of Fill: \_\_\_\_\_  
 Source of Fill \_\_\_\_\_  
 Bentonite Plugs: From \_\_\_\_\_ to \_\_\_\_\_ From \_\_\_\_\_ to \_\_\_\_\_

**Wells other than Bored Wells**  
 Casing removed, Y or N? \_\_\_\_\_  
 Depth to which casing was removed: \_\_\_\_\_  
 Applicable, depth(s), and type of gravel/sand fill: \_\_\_\_\_  
 Source of gravel or sand: \_\_\_\_\_  
 Cement: From \_\_\_\_\_ to \_\_\_\_\_ From \_\_\_\_\_ to \_\_\_\_\_

Method of permanently marking location: \_\_\_\_\_  
 Installed watertight top  
 Suggest setting pump @ approx. 40 ft.  
4" Well casing will begin at approx. 80 ft.

1-COR  
Common  
Dens

William W. Rawls, Jr.

19 Myrtle St.


Adewate Beach lots 401-402-403

Stafford

\* Drillers Log \*

Depth	Description of Formation or Sediment	Remarks
0 10	Sandy Red Clay	
10 70	Sand & Gravel	
70 85	Blue Clay	
85 100	Sandy Blue Clay	
100 117	Sand & Gravel	
117 120	Brown clay	

DIAGRAM  
(NOT TO SCALE)

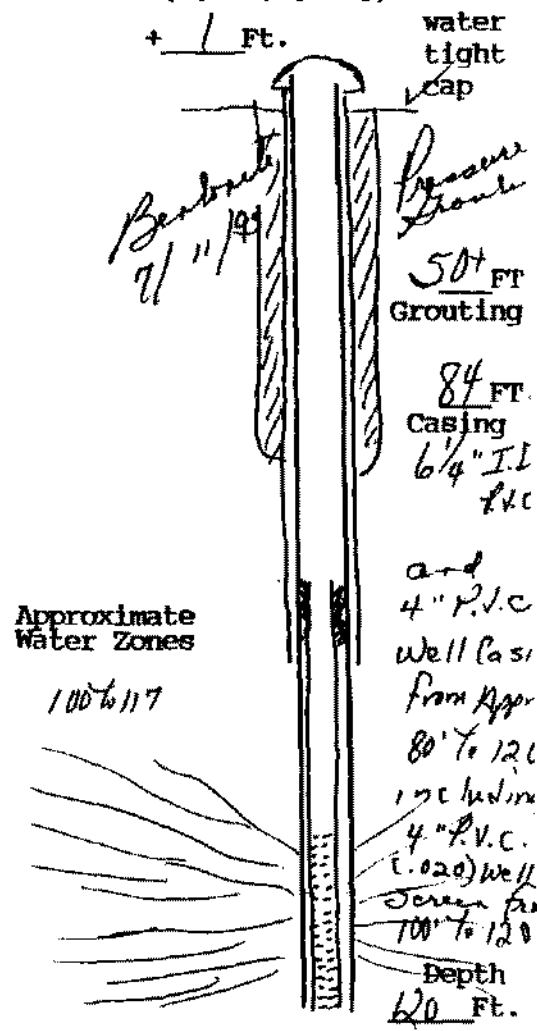

(Use additional Sheets if necessary)

I certify that the information contained here is true and that this well was installed and constructed in accordance with the permit and further that the well complies with all applicable state and local regulations, ordinances and laws.

Name: JOHN L. DANIELSON, JR., INC.  
 Address: 4616 HOOD DRIVE  
FREDERICKSBURG, VIRGINIA 22408  
 Phone: (703) 898-6025 & 898-9355

Drillers Signature: [Signature]  
 Date: 7/11/95 Representing: JOHN L. DANIELSON, JR., INC.

Virginia Contractors License Number: CLASS A 2701 014084A H/H WWC