

1711D

Richardson
Richardson Building Corp
1515 Gordon Rd
Charlottesville, Va. 22958
786-4785 / 786-2450 / 786-3533
Owner Richard "Dick" Meyer
Address 807 South Hoya St
Sterling VA 20164
Phone 1-703-430-6976 / 1-800-368-5242 ext 547
Location #621 Near Intersection W & C St

Commonwealth of Virginia
Uniform Water Well Completion Report

Permit issued to:
Rocco PIER MARZ
P.O. Box 2167
1-304-479-1323

Tax Map ID 41-128-281
VDH Permit 05-94-50
VWCB Permit _____
VWCB ID _____
County Stafford
2/9/94 Kit Snyder
2/9/94 T.T. Thompson

Well Classification IIIA IIIB IIIC IV
* Well Data *

General Information
Dig Method Rotary
Depth to Bedrock _____
Static Water Level 100'
Well Disinfected (Y or N) _____

Date Completed 4/3/94
Yield 15 (GPM)
Stabilized Water Level 150'
Disinfectant Used _____

Total Depth of Well 270'
Length of Test approx. 2 hrs
Natural Flow (Rate) _____
Amount Used _____

Casing
From 1 To 80
Size 6 1/4" Material P.V.C.
Weight/Schedule SDR 27

From 80 To 100
Size 6 1/8" Material P.V.C.
Weight/Schedule SDR 21

From 90' To 250'
Size 4" Material P.V.C.
Weight/Schedule Sch. 40

Level Pack
From _____ To _____
Grain size _____
Depth from _____ to _____ ft.
Grain Size 10" 4/10/94
Type Bentonite
Method Pressure Grouting

From _____ To _____
Grain size 7 1/8" from 55 to 100 ft.
Bore Hole Size _____
Type _____
Method _____

From _____ To _____
Grain size 6 1/8" from 100 to 270 ft.
Bore Hole Size _____
Type _____
Method _____

Filter Zones or Screened Intervals
From 250 To 270
Mesh Size 20 Diam 4" (P.V.C.)

From 252 To 270
Mesh Size _____ Diam _____

From _____ To _____
Mesh Size _____ Diam _____

* Use Data *

Use Well: Domestic Agricultural _____ Industrial _____ Monitoring _____
Use Well: Community _____ Non Community _____

* Abandonment Information *

For Dug Wells
Removed, Y or N? _____
Depth to which casing was removed: _____
Depth and Type of Fill: _____
Source of Fill _____
Bentonite Plugs: From _____ to _____ From _____ to _____

Wells other than Bored Wells
Casing removed, Y or N? _____
Depth to which casing was removed: _____
Applicable, depth(s), and type of gravel/sand fill: _____
Source of gravel or sand: _____
Cement: From _____ to _____ From _____ to _____


Method of permanently marking location:
 Installed watertight top
 Best setting pump @ approx. 190 ft.

Building Corp
Dick Meyer
Stafford

* Drillers Log *

Depth	Description of Formation or Sediment	Remarks
0	25	Sandy Red Clay
25	80	Black Sand
80	110	Marl
110	165	Black Sand
165	178	Brown Clay
178	187	Gray Clay
187	215	Gray Sandy Clay
215	230	Brown Clay
230	250	Sandy Gray Clay
250	270	Gray & white sand

DIAGRAM
(NOT TO SCALE)

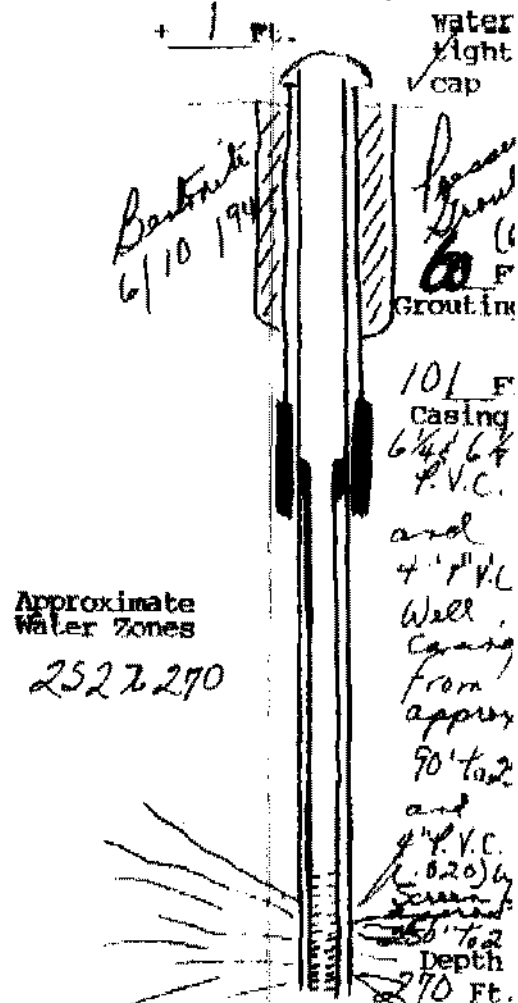

(Use additional Sheets if necessary)

I certify that the information contained here is true and that this well was installed and constructed in accordance with the permit and further that the well complies with all applicable state and local regulations, ordinances and laws.

Company JOHN L. DANIELSON, JR., INC.
 Address 4616 HOOD DRIVE
FREDERICKSBURG, VIRGINIA 22408
 Phone (703) 898-6025 / 898-9355

Drillers Signature [Signature]
 Date 6/10/94 Representing JOHN L. DANIELSON, JR., INC.

Virginia Contractors License Number CLASS A 2701 014084A H/H WVC