


COMMONWEALTH OF VIRGINIA

WATER WELL COMPLETION REPORT

BWCM No. _____

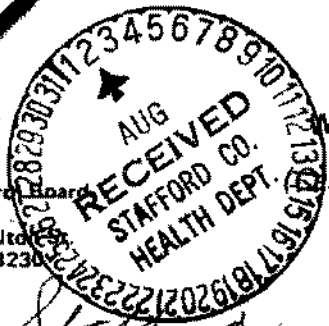

Water Control Board
P.O. Box 11143
2111 North Hamilton
Richmond, Va. 23220

Certification of Completion/County Permit)

Chas. Kelley Smith
P.O. Box 11108
Stafford Co. 22554
659-7480

SWCB Permit _____
County Permit _____
Certification of inspecting official:
This well does _____ does not _____
meet code/low requirements.
S. _____
Date _____
For Office Use

County/City Stafford

County/City Stamp

Virginia Plane Coordinates
N _____ E _____
Latitude & Longitude
N _____ W _____
Topo. Map No. 183D
Elevation _____ ft.
Formation _____
Lithology _____
River Basin _____
Province _____
Type Logs D. L.
Cuttings N. A.
Water Analysis _____
Aquifer Test _____

Owner - Fox Sub -
Well Designation or Number _____
Address _____
Phone _____
Drilling Contractor John L. Danielson, Jr., Inc.
Address 4616 Hood Drive
Fredericksburg, Virginia 22401
Phone (703) 898-6025

189-88-155 ^{37/88} Oris Meadows
Tax Map I.D. No. 42-14-31
Subdivision Lower Ridge Estates
Section I
Block _____
Lot 31
Class Well: I _____, IIA _____
IIB _____, IIIA _____, IIIB
IIIC _____, IIID _____, IIIE _____

WELL LOCATION: 3 (feet/miles) South (direction) of intersection of 655 & 17
and 3/10 (feet/miles) E. (direction) of #655
(If possible please include map showing location marked)
Water rose 3 ft. in 30 min. @ time of installation
24" I.D. casing holds 23.5 gal. of water per foot.
Date started 7/25/88 Date completed 7/25/88 Type rig Boring Rig
Approximate Drawdown 20 ft.

1. WELL DATA: New Reworked _____ Deepened _____
Total depth 50 ft. On
Depth to bedrock _____ ft. Rock
Hole size (Also include reamed zones)
• 39 inches from 0 to 20 ft.
• 27 inches from 20 to 50 ft.
Casing size (I.D.) and material
• 24 inches from 7.1 to 50 ft.
Material cement Concrete Casing
Wt per foot _____ or wall thickness _____ in.
Screen size and mesh for each zone (where applicable)
• From _____ to _____ ft.
• Mesh size _____ Type _____
• From _____ to _____ ft.
• Mesh size _____ Type _____
• From _____ to _____ ft.
• Mesh size _____ Type _____
Gravel pack
• From _____ to _____ ft.
• From _____ to _____ ft.
Grout
• From _____ to _____ ft., Type _____
• From _____ to _____ ft., Type _____

2. WATER DATA • Water temperature _____ °C
• Static water level (unpumped level measured) 25
• Stabilized measured pumping water level 45
• Stabilized yield _____ gpm after _____ hours
Natural Flow: Yes _____ No flow rate _____ g pi
Comment on quality _____
3. WATER ZONES: From 25 To 35
From _____ To _____ From _____ To _____
4. USE DATA:
Type of use: Drinking Livestock Watering _____
Irrigation _____ Food processing _____ Household
Manufacturing _____ Fire safety _____ Cleaning _____
Recreation _____ Aesthetic _____ Cooling or heating _____
Injection _____ Other _____
• Type of facility: Domestic Public water supply _____
Public institution _____ Farm _____ Industry _____
Commercial _____ Other _____
5. PUMP DATA: Type _____ Rated H.P. _____
• Intake depth _____ Capacity _____ at _____ head
6. WELLHEAD: Type well seal _____
Pressure tank _____ gal., Loc. _____
Sample tap _____ Measurement port _____
Well vent _____ Pressure relief valve _____
Gate valve _____ Check valve (when required) _____
Electrical disconnect switch on power supply _____
7. DISINFECTION: Well disinfected _____ yes _____ no _____
Date _____ Disinfectant used _____
Amount _____ Hours used _____
8. ABANDONMENT (where applicable) • yes _____ no _____
Casing pulled yes _____ no _____ not applicable _____
Plugging grout From _____ to _____ material _____
Pump installation through Smith

Gravel Backfill Grout

