

Smith Enterprises

Owner Ann Riley Smith
River Ridge, Est. #21 4655 44 77
 Staffed

Richmond, Va. 23230
 11 North Main Street
 State Water Control Board


9. State law requires submitting to the Virginia State Water Control Board information about groundwater and wells for intended for water, or any other non-exempt well. This information must be submitted whether the well is completed. Information required includes: an accurately and completely prepared water well completion report, full data from any cuttings taken at ten foot intervals (unless exemption is secured), the results of any chemical analyses, and copies of any geophysical pumpage and use reports are required from owners of public supply and industrial wells. County or State permits to drill may be required in the state. Some counties require submission of a water well completion report. The Virginia State Health Department requires a water well report for public supply wells.

10. DRILLERS LOG (use additional Sheets if necessary)

DEPTH (feet)		TYPE OF ROCK OR SOIL (color, material, fossils, hardness, etc.)	REMARKS (water, caving, cavities, broken, core, shot, etc.)
From	To		
0	10	Red clay	
10	30	Micaceous formation / Red	
30	50	Micaceous formation / Brown	
50	62	Broken rock	
62	100	soft brown rock	} inserted 4" liner screen
100	220	soft blue rock	

Approximate
Water zones
211 to 212

11. 12. DIAGRAM OF WELL CONSTRUCTION (with dimensions)

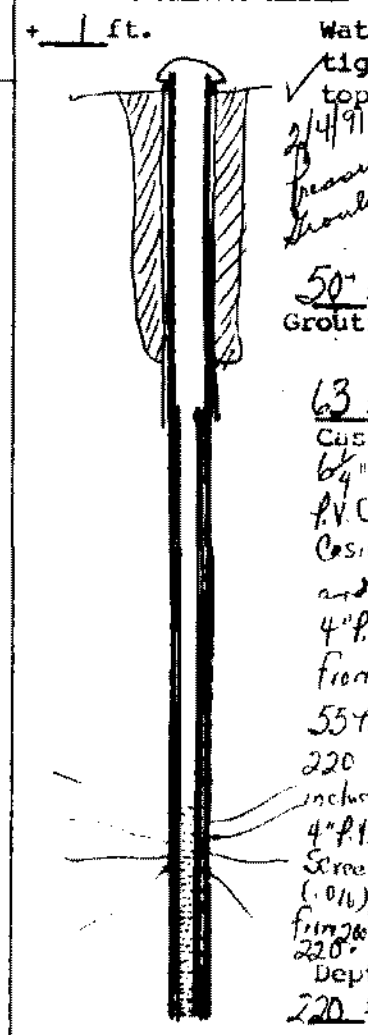

13. Well lot dedicated? _____ Size _____ ft. X _____ ft. Well house? _____
 Distance to nearest pollutant source _____ ft. Type _____
 Distance to nearest property line _____ ft. Building _____ ft.

14. WATER SERVICE PIPE: Checked under _____ p.s.i. for _____
 minutes. Pipe size _____ inches, Material _____
 Installer _____
 Date _____

15. I certify that the information contained herein is true and correct and that this well and/or system has been installed and constructed in accordance with the requirements for well construction as specified in compliance with appropriate county or independent city ordinances and the laws and rules of the Commonwealth of Virginia.

Signature Ann Riley Smith Date 2/4/91
 (Well driller or authorized person) License No. _____

- ### State Water Control Board Regional Offices
- Valley Reg. Off.
116 North Main Street
P. O. Box 268
Bridgewater, Va. 22812
703 828 2595
 - Southwest Reg. Off.
408 East Main Street
P. O. Box 476
Abingdon, Va. 24210
703 628 5183
 - West Central Reg. Off.
Executive Park
5312 Peters Creek Road
Roanoke, Va. 24019
703 - 982 - 7432
 - Piedmont Reg. Off.
4010 West Broad Street
P. O. Box 6616
Richmond, Va. 23230
804 257-1006
 - Tidewater Reg. Off.
287 Pembroke Office Park
Suite 310 Pembroke No. 2
Va. Beach, Va. 23462
804-499-8742
 - Northern Virginia Reg. Off.
5515 Cherokee Avenue
Suite 404
Alexandria, Va. 22312
703-750-9111