

521 Holly Berry Road
Fredericksburg, Va. 22406
752-1600/752-4613 (Mob. 840-3197)

Commonwealth of Virginia
Uniform Water Well Completion Report

Owner Ronald Cummings
Address 521 Holly Berry Rd
Phone 702-4613
Location River Ridge Estates Sect 14 Lot 25 (Ridge Way Circle)
183 D 17 -> 655 / Near River
Well Classification IIIA IIIB IIIC IV
Approx 2 1/2 M. South of Jct. 655 + Ridge Dr. Well Data *
" 75 Ft. North of Ridge Drive

Tax Map ID 42-14-25
VDH Permit 5617-95-338
VWCB Permit _____
VWCB ID _____
County Stafford
11/3/95 Ashton B. Wright
DJC

General Information
Drilling Method Air Rotary
Depth to Bedrock 86'
Static Water Level 30'
Well Disinfected (Y or N) _____

Date Completed 1/5/96
Yield 25 (GPM)
Stabilized Water Level _____
Disinfectant Used _____

Total Depth of Well 200'
Length of Test approx 1 Hr
Natural Flow (Rate) _____
Amount Used _____

Casing
From 11 To 87
Size 6 1/4 Material P.V.C.
Weight/Schedule SDR 27

From 87 To 107
Size 6 1/2 Material P.V.C.
Weight/Schedule SDR 21

80' and 160'
From 180 To 200
Size 4" Material P.V.C.
Weight/Schedule Sch 40

Gravel Pack
From _____ To _____
Hole size 10" from 0 to 50ft.
Grout
From 0 To 50'
Bore Hole Size 10"
Type Bentonite
Method Pressure Grouting

From _____ To _____
7 1/8" from 50 to 107ft.
From _____ To _____
Bore Hole Size _____
Type _____
Method _____

From _____ To _____
6 1/8" from 107 to 200ft.
From _____ To _____
Bore Hole Size _____
Type _____
Method _____

Water Zones or Screened Intervals
From 160 To 180
Mesh Size .020 Diam 4" (P.V.C.)
From _____ To _____
Mesh Size _____ Diam _____

From 140 To 141
Mesh Size _____ Diam _____
From 170 To 171
Mesh Size _____ Diam _____

From _____ To _____
Mesh Size _____ Diam _____
From _____ To _____
Mesh Size _____ Diam _____

* Use Data *

Private Well: Domestic Agricultural _____ Industrial _____ Monitoring _____
Public Well: Community _____ Non Community _____

* Abandonment Information *

Bored or Dug Wells
Casing Removed, Y or N?: _____
If Y, Depth to which casing was removed: _____
Depth and Type of Fill: _____
Source of Fill _____
Bentonite Plugs: From _____ to _____ From _____ to _____

Wells other than Bored Wells
Casing removed, Y or N? _____
Depth to which casing was removed: _____
Applicable, depth(s), and type of gravel/sand fill: _____
Source of gravel or sand: _____
Cement: From _____ to _____ From _____ to _____



Method of permanently marking location: _____
 Installed watertight top
Suggest setting pump @ approx. _____ ft.
You will encounter 4" casing @ approx 80 ft.
Suggest keeping sealers & torque arresters out of 4" casing.

Ronald Cummings
River Bridge, Culpeper
Stafford 655
 17 → *655 to Ridgeway Circle
 Drillers Log

Depth Description of Formation or Sediment Remarks

0	10	Red Clay
10	85	Brown Clay
85	107	Soft Brown Shale
107	200	Grey Shale

DIAGRAM
 (NOT TO SCALE)

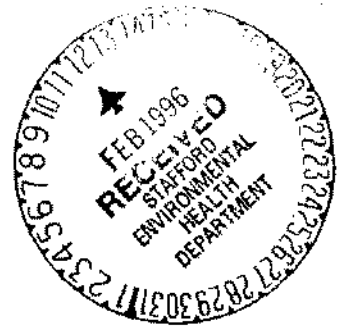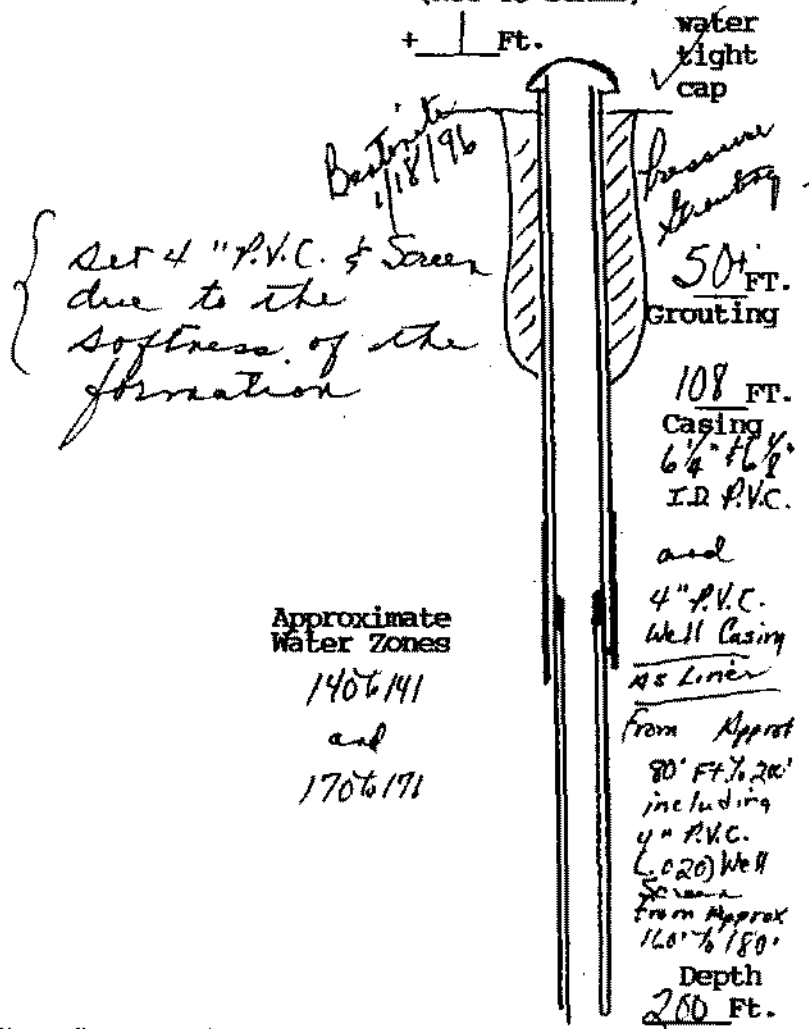

(User additional Sheets if necessary)

I certify that the information contained here is true and that this well was installed and constructed in accordance with the permit and further that the well complies with all applicable state and local regulations, ordinances and laws.

Name JOHN L. DANIELSON, JR., INC.
 Address 4616 HOOD DRIVE
FREDERICKSBURG, VIRGINIA 22408
 Phone (703) 898-6025 / 898-9355

Drillers Signature [Signature]
 Date 1/18/96 Representing JOHN L. DANIELSON, JR., INC.

Virginia Contractors License Number CLASS A 2701 014084A H/H WWC