

**Commonwealth of Virginia  
Uniform Water Well Completion Report**

*Myart*  
Box 13965  
Fredericksburg, Va.  
22402  
2100/898-2273

Owner Stuart E. Susan Richards  
 Address 26575 Hill Road

Tax Map ID 42-14-13  
 VDH Permit W-94-440  
 VWCB Permit \_\_\_\_\_  
 VWCB ID \_\_\_\_\_  
 County STAFFORD  
10/25/94 Rob Snyder

Phone \_\_\_\_\_  
 Location River Ridge Col. - Sect 14 - Lot 13  
183D

Well Classification IIIA IIIR ✓ IIIC IV  
approx 2 M. South of Inter of 6557659 • Well Data •  
3/10 M. East of • 655

**General Information**

Drilling Method <u>Aug Rotary</u>	Date Completed <u>11/9/94</u>	Total Depth of Well <u>480'</u>
Depth to Bedrock <u>42</u>	Yield <u>12</u> (GPM)	Length of Test _____
Static Water Level <u>approx 40'</u>	Stabilized Water Level <u>approx 40'</u>	Natural Flow (Rate) _____
Well Disinfected (Y or N) _____	Disinfectant Used _____	Amount Used _____

**Casing**

From <u>±1</u> To <u>52</u>	From _____ To _____	From _____ To _____
Size <u>6 1/4</u> Material <u>P.V.C.</u>	Size _____ Material _____	Size _____ Material _____
Weight/Schedule <u>SDR 27</u>	Weight/Schedule _____	Weight/Schedule _____

**Gravel Pack**

From _____ To _____	From _____ To _____	From _____ To _____
---------------------	---------------------	---------------------

**Hole size**

<u>10"</u> From <u>0</u> to <u>52</u> ft.	<u>6 1/4"</u> from <u>52</u> to <u>480'</u> ft.	" from _____ to _____ ft.
---	---	---------------------------

**Grout**

From <u>0</u> To <u>11 1/2</u>	From _____ To _____	From _____ To _____
Bore Hole Size <u>10"</u>	Bore Hole Size _____	Bore Hole Size _____
Type <u>Bentonite</u>	Type _____	Type _____
Method <u>Pressure Grouting</u>	Method _____	Method _____

**Water Zones or Screened Intervals**

From <u>200</u> To <u>201</u>	From _____ To _____	From _____ To _____
Mesh Size _____ Diam _____	Mesh Size _____ Diam _____	Mesh Size _____ Diam _____
From <u>450</u> To <u>451</u>	From _____ To _____	From _____ To _____
Mesh Size _____ Diam _____	Mesh Size _____ Diam _____	Mesh Size _____ Diam _____

\* Use Data \*

Private Well: Domestic  Agricultural \_\_\_\_\_ Industrial \_\_\_\_\_ Monitoring \_\_\_\_\_  
 Public Well: Community \_\_\_\_\_ Non Community \_\_\_\_\_

**\* Abandonment Information \***

**Bored or Dug Wells**

Casing Removed, Y or N? \_\_\_\_\_  
 If Y, Depth to which casing was removed: \_\_\_\_\_  
 Depth and Type of Fill: \_\_\_\_\_  
 Source of Fill \_\_\_\_\_  
 Bentonite Plugs: From \_\_\_\_\_ to \_\_\_\_\_ From \_\_\_\_\_ to \_\_\_\_\_

**Wells other than Bored Wells**

Casing removed, Y or N? \_\_\_\_\_  
 Depth to which casing was removed: \_\_\_\_\_  
 Applicable, depth(s), and type of gravel/sand fill: \_\_\_\_\_  
 Source of gravel or sand: \_\_\_\_\_  
 Cement: From \_\_\_\_\_ to \_\_\_\_\_ From \_\_\_\_\_ to \_\_\_\_\_

Method of permanently marking location:


Installed watertight top  
 Suggest setting pump @ approx. 300 ft.

George O. Bryant  
Mayor of Warrenton  
Kevin Ridge #13  
Stafford 655

\* Drillers Log \*

Depth	Description of Formation or Sediment	Remarks
0	10	Red Clay
10	42	Brown Clay
42	52	Soft Brown Shale
52	370	Dark Grey Rock
370	480	Light Grey Rock

DIAGRAM  
(NOT TO SCALE)

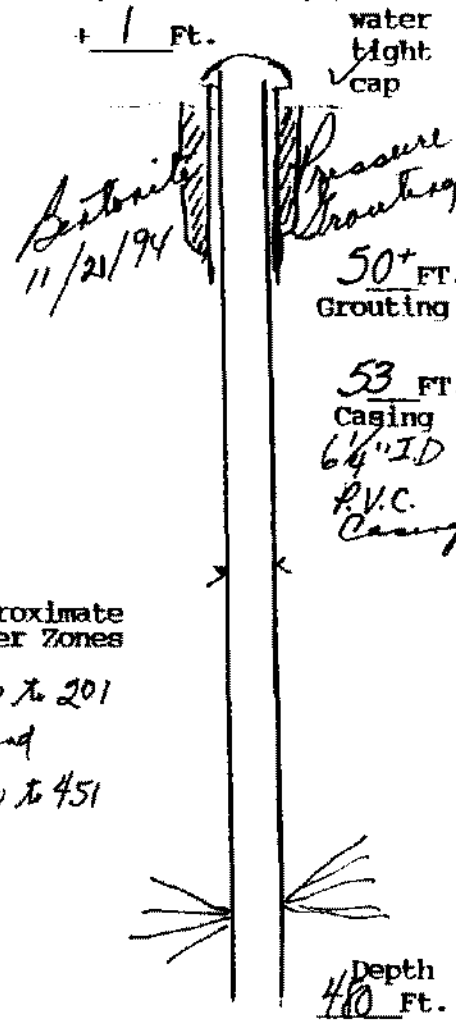

Approximate  
Water Zones  
200 to 201  
and  
450 to 451

(Use additional Sheets if necessary)

I certify that the information contained here is true and that this well was installed and constructed in accordance with the permit and further that the well complies with all applicable state and local regulations, ordinances and laws.

Name JOHN L. DANIELSON, JR., INC.  
 Address 4616 HOOD DRIVE  
FREDERICKSBURG, VIRGINIA 22408  
 Phone (703) 898-6025 / 898-9355

Drillers Signature John L. Danielson, Pres.  
 Date 11/21/94 Representing JOHN L. DANIELSON, JR., INC.

Virginia Contractors License Number CLASS A 2701 014084A II/II WVC