

**Commonwealth of Virginia
Uniform Water Well Completion Report**

Owner Robert Ayers
 Address 4 River Ridge Lane
Fredericksburg, Va. 22406
 Phone 1-703-455-7854
 Location River Ridge Est - Lot 36

Tax Map ID 42-14-36
 VDH Permit W-95-31
 VWCB Permit _____
 VWCB ID _____
 County Stafford
13195 Cottonwright

Well Classification IIIA _____ IIIR IIIC _____ IV _____
 * Well Data *

General Information

Drilling Method Air Rotary
 Depth to Bedrock 110'
 Static Water Level approx 50'
 Well Disinfected (Y or N) _____

Date Completed 2/3/95
 Yield 12 (GPM)
 Stabilized Water Level approx 220'
 Disinfectant Used _____

Total Depth of Well 280'
 Length of Test approx 1 Hr
 Natural Flow (Rate) _____
 Amount Used _____

Casing

From 1 To 142
 Size 6 1/4" Material steel
 Weight/Schedule 13.1 lb per ft, 1988

From 130 To 240
 Size 4" Material P.V.C.
 Weight/Schedule Sch 40

From 260 To 280
 Size 4" Material P.V.C.
 Weight/Schedule Sch 40

Gravel Pack

From _____ To _____

From _____ To _____

From _____ To _____

Hole size 10" from 0 to 60 ft.

7 7/8" from 60 to 142 ft.

6 8" from 142 to 280 ft.

Grout From 0 To 50'

From _____ To _____

From _____ To _____

Bore Hole Size 10" 2/3/95
 Type Bentonite
 Method Pressure Grouting

Bore Hole Size _____
 Type _____
 Method _____

Bore Hole Size _____
 Type _____
 Method _____

Water Zones or Screened Intervals

From 240 To 260
 Mesh Size .020 Diam 4" (P.V.C.)
 From _____ To _____
 Mesh Size _____ Diam _____

approx water zone
 From 243 To 244
 Mesh Size _____ Diam _____
 From _____ To _____
 Mesh Size _____ Diam _____

From _____ To _____
 Mesh Size _____ Diam _____
 From _____ To _____
 Mesh Size _____ Diam _____

*** Use Data ***

Private Well: Domestic Agricultural _____ Industrial _____ Monitoring _____
 Public Well: Community _____ Non Community _____

*** Abandonment Information ***

Bored or Dug Wells

Casing Removed, Y or N? _____
 If Y, Depth to which casing was removed: _____
 Depth and Type of Fill: _____
 Source of Fill _____
 Bentonite Plugs: From _____ to _____ From _____ to _____

Wells other than Bored Wells

Casing removed, Y or N? _____
 Depth to which casing was removed: _____
 Applicable, depth(s), and type of gravel/sand fill: _____
 Source of gravel or sand: _____
 Cement: From _____ to _____ From _____ to _____

Method of permanently marking location:

Installed watertight top
 Suggest setting pump @ approx. 160 ft.

you will encounter 4" casing @ approx 130 ft.
Suggest keeping torque arrestors & centralizers out of 4" casing

Robert Ayers
4 River Ridge Lane
River Ridge Est Lot 36
Stafford


* Drillers Log *

Depth

Description of Formation or Sediment

Remarks

0	10	Red Clay
10	40	Mucaceous formation red
40	80	Mucaceous formation brown
80	110	Brown Sand
110	280	Blue Shale { set 4" P.V.C. Screen due to softness of formation

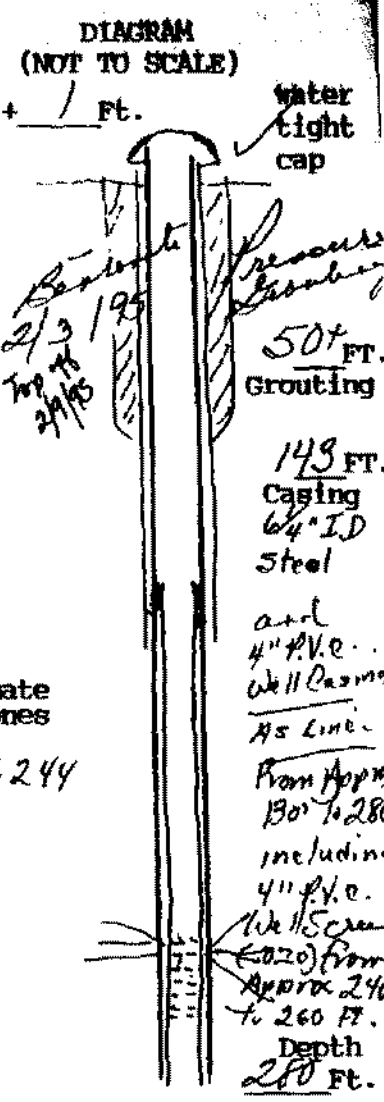

Approximate Water Zones

243 to 244



(User additional Sheets if necessary)

I certify that the information contained here is true and that this well was installed and constructed in accordance with the permit and further that the well complies with all applicable state and local regulations, ordinances and laws.

Name JOHN L. DANIELSON, JR., INC.
 Address 4616 HOOD DRIVE
FREDERICKSBURG, VIRGINIA 22408
 Phone (703) 898-6025 / 898-9355

Drillers Signature John L. Danielson, Jr., Pres.
 Date 2/9/95 Representing JOHN L. DANIELSON, JR., INC.

Virginia Contractors License Number CLASS A 2701 014084A H/H WMC