

**Commonwealth of Virginia
Uniform Water Well Completion Report**

Darlene & Ray Rollins
 Address 58 Dent Road
Stafford, Va. 22559
 Phone 659-7351
 Location J. Walter Road Sub. # 3A (Holly Corner Rd)
183 D
 Well Classification IIIA IIIB IIIC IV
 approx. 3 M. S. of Jct of 17th 655 * Well Data *
 200' East of # 655

Tax Map ID 42-13-3A
 VDH Permit WS-13-353
 VWCB Permit _____
 VWCB ID _____
 County Stafford
1/27/94 Daniel Josselyn
TT Thompson

General Information
 Drilling Method Air Rotary
 Depth to Bedrock 30
 Static Water Level approx 40'
 Well Disinfected (Y or N) _____

Date Completed 7/11/94
 Yield 30 (GPM)
 Stabilized Water Level approx 100'
 Disinfectant Used _____

Total Depth of Well 200'
 Length of Test approx 1 Hr.
 Natural Flow (Rate) _____
 Amount Used _____

Casing
 From 4' To 6'
 Size 6 1/4" Material P.V.C.
 Weight/Schedule SDR 27

From _____ To _____
 Size _____ Material _____
 Weight/Schedule _____

From _____ To _____
 Size _____ Material _____
 Weight/Schedule _____

Gravel Pack
 From _____ To _____
 Hole size 10" from 0 to 6 ft.
 Grout From 0 To 50 7/12/94
 Bore Hole Size 10"
 Type Bentonite
 Method Pressure Grouting

From _____ To _____
 Hole size 6 1/4" from 61 to 200 ft.
 Grout From _____ To _____
 Bore Hole Size _____
 Type _____
 Method _____

From _____ To _____
 Hole size _____ from _____ to _____ ft.
 Grout From _____ To _____
 Bore Hole Size _____
 Type _____
 Method _____

Water Zones or Screened Intervals
 From 120 To 121
 Mesh Size _____ Diam _____
 From 180 To 181
 Mesh Size _____ Diam _____

From _____ To _____
 Mesh Size _____ Diam _____
 From _____ To _____
 Mesh Size _____ Diam _____

From _____ To _____
 Mesh Size _____ Diam _____
 From _____ To _____
 Mesh Size _____ Diam _____

* Use Data *

Private Well: Domestic Agricultural _____ Industrial _____ Monitoring _____
 Public Well: Community _____ Non Community _____

* Abandonment Information *

Bored or Dug Wells
 Casing Removed, Y or N? _____
 If Y, Depth to which casing was removed: _____
 Depth and Type of Fill: _____
 Source of Fill _____
 Bentonite Plugs: From _____ to _____ From _____ to _____

Wells other than Bored Wells
 Casing removed, Y or N? _____
 Depth to which casing was removed: _____
 Applicable, depth(s), and type of gravel or sand: _____
 Source of gravel or sand: _____
 Cement: From _____ to _____ From _____ to _____

Method of permanently marking location:
 Installed watertight top
 Suggest setting pump @ approx. 120 ft.




Darlene Rollins
J. Walter Reed 3A
Holly Corner Rd.

* Drillers Log *

101' W
 Wealth of
 Department

Depth	Description of Formation or Sediment	Remarks
0	10	Red Clay
10	30	Brown Clay
30	40	Brown Rock
40	200	Light Grey Granite

DIAGRAM
 (NOT TO SCALE)

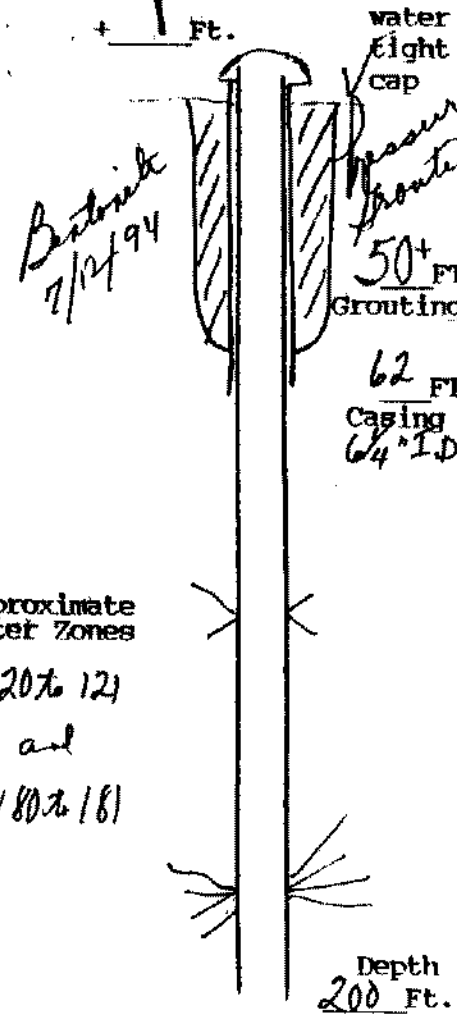

Approximate
 Water Zones
 120 to 121
 and
 180 to 181

(Use additional Sheets if necessary)

I certify that the information contained here is true and that this well was installed and constructed in accordance with the permit and further that the well complies with all applicable state and local regulations, ordinances and laws.

Name JOHN L. DANIELSON, JR., INC.
 Address 4616 HOOD DRIVE
FREDERICKSBURG, VIRGINIA 22408
 Phone (703) 896-6025 / 898-9355

Drillers Signature John L. Danielson, Pres.
 Date 7/12/94 Representing JOHN L. DANIELSON, JR., INC.

Virginia Contractors License Number CLASS A 2701 014084A H/H WWC