


COMMONWEALTH OF VIRGINIA
 WATER WELL COMPLETION REPORT
 (Certification of Completion/County Permit)

BWCM No. 43-76-2-4

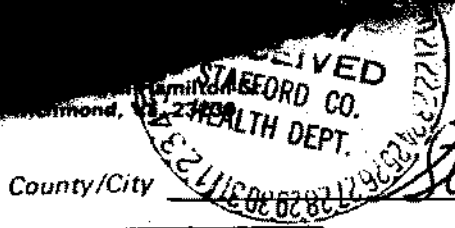

County/City Stafford

County/City Stamp
Stafford

SWCB Permit _____
 County Permit _____
 Certification of inspecting official:
 This well does _____ does not _____
 meet code/low requirements.
 S. _____
 Date _____
 For Office Use

Virginia Plane Coordinates
 N _____
 E _____
 Latitude & Longitude _____
 N _____
 W _____
 Topo. Map No. _____
 Elevation _____ ft.
 Formation _____
 Lithology _____
 River Basin _____
 Province _____
 Type Logs _____
 Cuttings _____
 Water Analysis _____
 Aquifer Test _____

Owner Richard Bryant
 Well Designation or Number _____
 Address 4502 Commons Dr. #201
Annandale Va 22003
 Phone 941-3620
 Drilling Contractor R. L. Curtis Well Co
 Address RT. 2, Box 145
Bealton Va
 Phone 439-8377

Tax Map I.D. No. 43-76
 Subdivision Berea Estates
 Section II
 Block _____
 Lot 4
 Class Well: I _____, IIA _____
 IIB _____, IIA , IIB _____
 IIC _____, IID _____, IIE _____

WELL LOCATION: _____ (feet/miles _____ direction) of _____
 and _____ feet/miles _____ (direction) of _____
 (If possible please include map showing location marked)
 Date started 6/10/87 Date completed 6/10/87 Type rig air

I. WELL DATA: New Reworked _____ Deepened _____
 Total depth 245 ft.
 Depth to bedrock 26 ft.
 Hole size (Also include reamed zones)
 • 10 inches from 0 to 36 ft.
 • 6 inches from 36 to 245 ft.
 Casing size (I.D.) and material
 • 6 inches from 0 to 36 ft.
 Material Steel
 Wt. per foot 13 or wall thickness 188 in.
 Screen size and mesh for each zone (where applicable)
 • Mesh size _____ Type _____
 • Mesh size _____ Type _____
 • Mesh size _____ Type _____
 • Mesh size _____ Type _____
 Gravel pack
 • From _____ to _____ ft.
 • From _____ to _____ ft.
 Grout
 • From 0 to 30 ft., Type Pressure
 • From _____ to _____ ft., Type _____

2. WATER DATA • Water temperature _____ of _____
 • Static water level (unpumped level-measured) _____ ft.
 • Stabilized measured pumping water level 244 ft.
 • Stabilized yield 2 1/2 gpm after 4 hours
 Natural Flow: Yes _____ No _____, flow rate _____ gpm
 Comment on quality _____
 3. WATER ZONES: From _____ To _____
 From _____ To _____ From _____ To _____
 From _____ To _____ From _____ To _____
 4. USE DATA:
 Type of use: Drinking Livestock Watering _____
 Irrigation _____ Food processing _____ Household
 Manufacturing _____ Fire safety _____ Cleaning _____
 Recreation _____ Aesthetic _____ Cooling or heating _____
 Injection _____ Other _____
 • Type of facility: Domestic Public water supply _____
 Public institution _____ Farm _____ Industry _____
 Commercial _____ Other _____
 5. PUMP DATA: Type _____ Rated H.P. _____
 • Intake depth _____ Capacity _____ at _____ head
 6. WELLHEAD: Type well seal _____
 Pressure tank _____ gal., Loc. _____
 Sample tap _____ Measurement port _____
 Well vent _____ Pressure relief valve _____
 Gate valve _____ Check valve (when required) _____
 Electrical disconnect switch on power supply _____
 7. DISINFECTION: Well disinfected _____ yes _____ no _____
 Date _____ Disinfectant used _____
 Amount _____ Hours used _____
 8. ABANDONMENT (where applicable) • yes _____ no _____
 Casing pulled yes _____ no _____ not applicable _____
 Plugging grout From _____ to _____ material _____

Owner Richard Bryant

BWCM No. _____

9. State law requires submitting to the Virginia State Water Control Board information about groundwater and wells for every well made in the State intended for water, or any other non-exempt well. This information must be submitted whether the well is completed, on standby, or abandoned. Information required includes: an accurately and completely prepared water well completion report, full data from any aquifer pumping tests, drill cuttings taken at ten foot intervals (unless exemption is secured), the results of any chemical analyses, and copies of any geophysical logs. Quarterly pumpage and use reports are required from owners of public supply and industrial wells. County or State permits to drill may be required in some parts of the state. Some counties require submission of a water well completion report. The Virginia State Health Department requires a water well completion report for public supply wells.

10. DRILLERS LOG (use additional Sheets if necessary)

DEPTH (feet)		TYPE OF ROCK OR SOIL (color, material, fossils, hardness, etc.)	REMARKS (water, caving, cavities, broken, core, shot, etc.)	Drilling Time (Min.)
From	To			
0	26	brown sandy soil		
26	245	sand stone		

12. DIAGRAM OF WELL CONSTRUCTION (with dimensions)

Well 245 ft
36 ft casing
30 ft grout



13. Well lot dedicated? _____; Size _____ ft. X _____ ft.; Well house? _____
Distance to nearest pollutant source _____ ft. Type _____
Distance to nearest property line _____ ft. Building _____ ft.

14. WATER SERVICE PIPE: Checked under _____ p.s.i. for _____ minutes. Pipe size _____ inches, Material _____
Installer _____
Date _____

15. I certify that the information contained herein is true and correct and that this well and/or system has been installed and constructed in accordance with the requirements for well construction as specified in compliance with appropriate county or independent city ordinances and the laws and rules of the Commonwealth of Virginia.

Signature Raymond L Curtis (Seal), Date 6/10/87
(Well driller or authorized person) License No. _____

State Water Control Board Regional Offices

Valley Reg. Off.
116 North Main Street
P. O. Box 268
Bridgewater, Va. 22812
703-828-2595

Southwest Reg. Off.
408 East Main Street
P. O. Box 476
Abingdon, Va. 24210
703-628-5183

West Central Reg. Off.
Executive Park
5312 Peters Creek Road
Roanoke, Va. 24019
703-982-7432

Piedmont Reg. Off.
4010 West Broad Street
P. O. Box 6616
Richmond, Va. 23230
804-257-1006

Tidewater Reg. Off.
287 Pembroke Office Park
Suite 310 Pembroke No. 2
Va. Beach, Va. 23462
804-499-8742

Northern Virginia Reg. Off.
5515 Cherokee Avenue
Suite 404
Alexandria, Va. 22312
703-750-9111