

# WATER WELL COMPLETION REPORT

• BWCN No. \_\_\_\_\_

(Certification of Completion/County Permit)

State Water Control Board  
P. O. Box 11143  
2111 North Hamilton St.  
Richmond, Va. 23230

County/City Stafford

County/City Stamp

• Virginia Plane Coordinates

N \_\_\_\_\_

E \_\_\_\_\_

Latitude & Longitude

N \_\_\_\_\_

W \_\_\_\_\_

• Topo. Map No. \_\_\_\_\_

• Elevation \_\_\_\_\_ ft.

• Formation \_\_\_\_\_

• Lithology \_\_\_\_\_

• River Basin \_\_\_\_\_

• Province \_\_\_\_\_

• Type Logs \_\_\_\_\_

• Cuttings \_\_\_\_\_

• Water Analysis \_\_\_\_\_

• Aquifer Test \_\_\_\_\_

• Owner Robert Phipps

• Well Designation or Number \_\_\_\_\_

Address 814 Warrenton Rd. Lot 25  
Fredericksburg, VA. 22405

Phone 373-7217

• Drilling Contractor Van's Construction Co., Inc.

Address P.O. Box 3306  
Fredericksburg, VA. 22401

Phone 373-7502

SWCB Permit \_\_\_\_\_

County Permit \_\_\_\_\_

Certification of inspecting official:  
This well does \_\_\_\_\_ does not \_\_\_\_\_  
meet code/low requirements.  
S. \_\_\_\_\_  
Date \_\_\_\_\_

*For Office Use*

Tax Map I.D. No. 43-19G

Subdivision \_\_\_\_\_

Section \_\_\_\_\_

Block \_\_\_\_\_

Lot \_\_\_\_\_

Class Well I \_\_\_\_\_ IIA \_\_\_\_\_

IIB \_\_\_\_\_ IIIA  IIIB \_\_\_\_\_

IIIC \_\_\_\_\_ IIID \_\_\_\_\_ IIIE \_\_\_\_\_

WELL LOCATION: \_\_\_\_\_ (feet/miles \_\_\_\_\_ direction) of \_\_\_\_\_  
and \_\_\_\_\_ feet/miles \_\_\_\_\_ (direction) of \_\_\_\_\_  
(If possible please include map showing location marked)

Date started 1-6-86 • Date completed 1-6-86 Type rig Rotary

**I. WELL DATA:** New  Reworked \_\_\_\_\_ Deepened \_\_\_\_\_

• Total depth 300 ft.

• Depth to bedrock 11 ft.

• Hole size (Also include reamed zones)

- 11 inches from 0 to 21 ft.
- 6 inches from 21 to 300 ft.
- \_\_\_\_\_ inches from \_\_\_\_\_ to \_\_\_\_\_ ft.

• Casing size (I.D.) and material

- 6 inches from 0 to 21 ft.

Material Steel

Wt. per foot 13 or wall thickness \_\_\_\_\_ in.

- \_\_\_\_\_ inches from \_\_\_\_\_ to \_\_\_\_\_ ft.

Material \_\_\_\_\_

Wt. per foot \_\_\_\_\_ or wall thickness \_\_\_\_\_ in.

- \_\_\_\_\_ inches from \_\_\_\_\_ to \_\_\_\_\_ ft.

Material \_\_\_\_\_

Wt. per foot \_\_\_\_\_ or wall thickness \_\_\_\_\_ in.

• Screen size and mesh for each zone (where applicable)

- \_\_\_\_\_ inches from \_\_\_\_\_ to \_\_\_\_\_ ft.
- Mesh size \_\_\_\_\_ Type \_\_\_\_\_
- \_\_\_\_\_ inches from \_\_\_\_\_ to \_\_\_\_\_ ft.
- Mesh size \_\_\_\_\_ Type \_\_\_\_\_
- \_\_\_\_\_ inches from \_\_\_\_\_ to \_\_\_\_\_ ft.
- Mesh size \_\_\_\_\_ Type \_\_\_\_\_
- \_\_\_\_\_ inches from \_\_\_\_\_ to \_\_\_\_\_ ft.
- Mesh size \_\_\_\_\_ Type \_\_\_\_\_

• Gravel pack

- From \_\_\_\_\_ to \_\_\_\_\_ ft.
- From \_\_\_\_\_ to \_\_\_\_\_ ft.

• Grout

- From \_\_\_\_\_ to \_\_\_\_\_ ft., Type \_\_\_\_\_
- From \_\_\_\_\_ to \_\_\_\_\_ ft., Type \_\_\_\_\_

**2. WATER DATA:** • Water temperature \_\_\_\_\_ of \_\_\_\_\_

• Static water level (unpumped level measured) 50 ft.

• Stabilized measured pumping water level \_\_\_\_\_ ft.

• Stabilized yield 8 gpm after 1 hours

Natural Flow: Yes \_\_\_\_\_ No  flow rate \_\_\_\_\_ g pm

Comment on quality clear

**3. WATER ZONES:** From 280 To \_\_\_\_\_

From \_\_\_\_\_ To \_\_\_\_\_ From \_\_\_\_\_ To \_\_\_\_\_

From \_\_\_\_\_ To \_\_\_\_\_ From \_\_\_\_\_ To \_\_\_\_\_

**4. USE DATA:**

Type of use: Drinking  Livestock Watering \_\_\_\_\_

Irrigation \_\_\_\_\_ Food processing \_\_\_\_\_ Household

Manufacturing \_\_\_\_\_ Fire safety \_\_\_\_\_ Cleaning \_\_\_\_\_

Recreation \_\_\_\_\_ Aesthetic \_\_\_\_\_ Cooling or heating \_\_\_\_\_

Injection \_\_\_\_\_ Other \_\_\_\_\_

• Type of facility: Domestic  Public water supply \_\_\_\_\_

Public institution \_\_\_\_\_ Farm \_\_\_\_\_ Industry \_\_\_\_\_

Commercial \_\_\_\_\_ Other \_\_\_\_\_

**5. PUMP DATA:** Type \_\_\_\_\_ • Rated H.P. \_\_\_\_\_

• Intake depth \_\_\_\_\_ • Capacity \_\_\_\_\_ at \_\_\_\_\_ head

**6. WELLHEAD:** Type well seal \_\_\_\_\_

Pressure tank \_\_\_\_\_ gal., Loc. \_\_\_\_\_

Sample tap \_\_\_\_\_ Measurement port \_\_\_\_\_

Well vent \_\_\_\_\_ Pressure relief valve \_\_\_\_\_

Gate valve \_\_\_\_\_ Check valve (when required) \_\_\_\_\_

Electrical disconnect switch on power supply \_\_\_\_\_

**7. DISINFECTION:** Well disinfected \_\_\_\_\_ yes \_\_\_\_\_ no \_\_\_\_\_

Date \_\_\_\_\_ Disinfectant used \_\_\_\_\_

Amount \_\_\_\_\_ Hours used \_\_\_\_\_

**8. ABANDONMENT (where applicable):** • yes \_\_\_\_\_ no \_\_\_\_\_


Casing pulled yes \_\_\_\_\_ no \_\_\_\_\_ not applicable \_\_\_\_\_

Plugging grout From \_\_\_\_\_ to \_\_\_\_\_ material \_\_\_\_\_

9. State law requires submitting to the Virginia State Water Control Board information about groundwater and wells for every well made in the State intended for water, or any other non-exempt well. This information must be submitted whether the well is completed, on standby, or abandoned. Information required includes: an accurately and completely prepared water well completion report, full data from any aquifer pumping tests, drill cuttings taken at ten foot intervals (unless exemption is secured), the results of any chemical analyses, and copies of any geophysical logs. Quarterly pumpage and use reports are required from owners of public supply and industrial wells. County or State permits to drill may be required in some parts of the state. Some counties require submission of a water well completion report. The Virginia State Health Department requires a water well completion report for public supply wells.

10. DRILLERS LOG (use additional Sheets if necessary)

10. DRILLERS LOG (use additional Sheets if necessary)			11.	12. DIAGRAM OF WELL CONSTRUCTION (with dimensions)
DEPTH (feet)		TYPE OF ROCK OR SOIL	REMARKS	Drilling Time (Min.)
From	To	(color, material, fossils, hardness, etc.)	(water, caving, cavities, broken, core, shot, etc.)	
0	11	clay rock		
11	300			

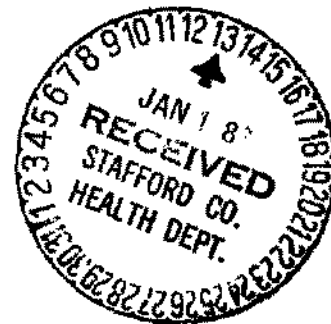

13. Well lot dedicated? \_\_\_\_\_; Size \_\_\_\_\_ ft X \_\_\_\_\_ ft., Well house? \_\_\_\_\_  
 Distance to nearest pollutant source \_\_\_\_\_ ft., Type \_\_\_\_\_  
 Distance to nearest property line \_\_\_\_\_ ft., Building \_\_\_\_\_ ft.

14. WATER SERVICE PIPE: Checked under \_\_\_\_\_ p. s. i. for \_\_\_\_\_ minutes. Pipe size \_\_\_\_\_ inches, Material \_\_\_\_\_  
 Installer \_\_\_\_\_  
 Date \_\_\_\_\_

15. I certify that the information contained herein is true and correct and that this well and/or system has been installed and constructed in accordance with the requirements for well construction as specified in compliance with appropriate county or independent city ordinances and the laws and rules of the Commonwealth of Virginia.

State Water Control Board Regional Offices

Valley Reg. Off.  
 116 North Main Street  
 P. O. Box 268  
 Bridgewater, Va. 22812  
 703-828-2595

Southwest Reg. Off.  
 408 East Main Street  
 P. O. Box 476  
 Abingdon, Va. 24210  
 703-628-5183

West Central Reg. Off.  
 Executive Park  
 5312 Peters Creek Road  
 Roanoke, Va. 24019  
 703-982-7432

Piedmont Reg. Off.  
 4010 West Broad Street  
 P. O. Box 6616  
 Richmond, Va. 23230  
 804-257-1006

Tidewater Reg. Off.  
 287 Pembroke Office Park  
 Suite 310 Pembroke No. 2  
 Va. Beach, Va. 23462  
 804-499-8742

Northern Virginia Reg. Off.  
 5515 Cherokee Avenue  
 Suite 404  
 Alexandria, Va. 22312  
 703-750-9111

Signature Sue Shelburt (Seal), Date 1-9-86  
 (Well driller or authorized person) License No \_\_\_\_\_