

Commonwealth of Virginia
Uniform Water Well Completion Report



Owner Bayside Builders Inc.
Address 104 Willowmere Pond Rd.
Stafford VA 22554
Phone 374-5777
Location Holly Corner Est. Lot # 46

Tax Map ID 43C-3-46
VDH Permit SWP-00-361
VWCB Permit _____
VWCB ID _____
County Stafford

Well Classification IIIA _____ IIIB IIIC _____ IV _____
* Well Data *

General Information
Drilling Method Air Rotary Date Completed 12/13/00 Total Depth of Well 280'
Depth to Bedrock 60' Yield 15 (GPM) Length of Test 1 hr.
Static Water Level 25' Stabilized Water Level _____ Natural Flow (Rate) N
Well Disinfected (Y or N) _____ Disinfectant Used _____ Amount Used _____

Casing
From +1/2' To 88 1/2' From _____ To _____ From _____ To _____
Size 6 1/4" EM Material PVC Size _____ Material _____ Size _____ Material _____
Weight/Schedule 3.441 # per ft. Weight/Schedule _____ Weight/Schedule _____
.250 wall

Gravel Pack
From _____ To _____ From _____ To _____ From _____ To _____
Hole size _____ " from _____ to _____ ft. _____ " from _____ to _____ ft. _____ " from _____ to _____ ft.
Output
From 70' To 0 From 88 1/2' To 70' From _____ To _____
Bore Hole Size 10 1/4" x 88 1/2' Bore Hole Size 10 1/4" x 88 1/2' Bore Hole Size _____
Type Bentonite E-Z seal Type Rock cuttings Type _____
Method pressure grout from bottom to top Method backfill from air! Method _____

Water Zones or Screened Intervals
From 160' To 162' From 266' To 268' From _____ To _____
Mesh Size _____ Diam _____ Mesh Size _____ Diam _____ Mesh Size _____ Diam _____
From _____ To _____ From _____ To _____ From _____ To _____
Mesh Size _____ Diam _____ Mesh Size _____ Diam _____ Mesh Size _____ Diam _____

* Use Data *

Private Well: Domestic Agricultural _____ Industrial _____ Monitoring _____
Public Well: Community _____ Non Community _____

* Abandonment Information *

<p>Bored or Bore Wells Casing Removed, Y or N? _____ If Y, Depth to which casing was removed: _____ Depth and Type of Fill: _____ Source of Fill: _____ Bentonite Plugs: From _____ to _____ From _____ to _____</p>	<p>Wells other than Bored Wells Casing removed, Y or N? _____ Depth to which casing was removed: _____ Applicable, depth(s), and type of gravel/sand fill: _____ Source of gravel or sand: _____ Cement: From _____ to _____ From _____ to _____</p>
--	--


Method of permanently marking location: Installed watertight top

• Drillers Log •

NOT TO SCALE
Remarks

Depth Description of Formation or Sediment

0	8'	Brown sandy clay
8'	20'	Red / brown clay
20'	60'	brown sandy clay
60'	85'	brown soft rock
85'	280'	grey granite

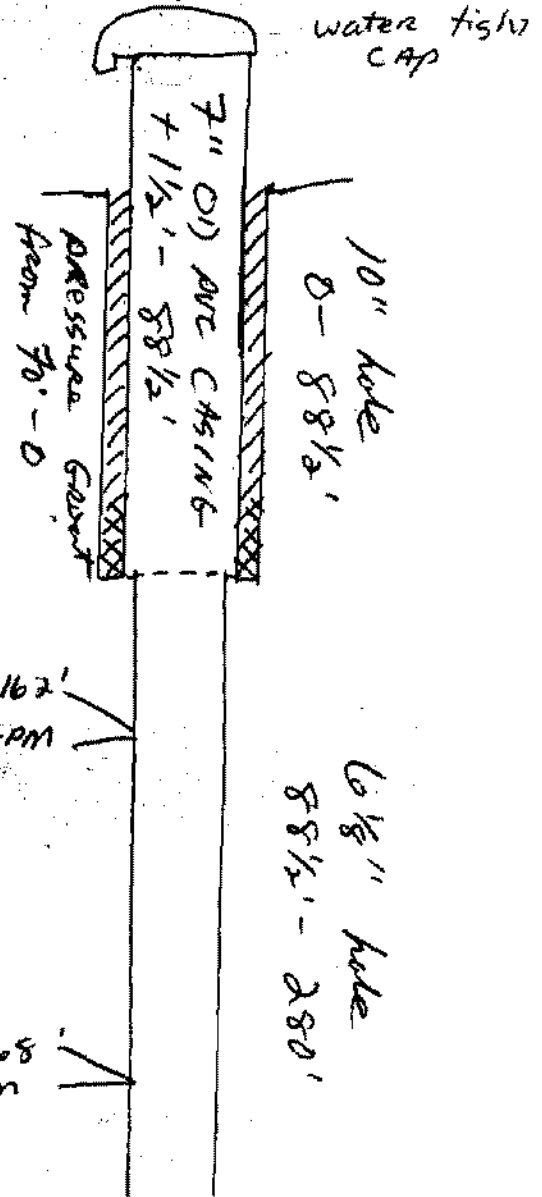

160'-162'
5 GPM

266'-268'
10 GPM

(User additional Sheets if necessary)

I certify that the information contained here is true and that this well was installed and constructed in accordance with the permit and that the well complies with all applicable state and local regulations, ordinances and laws.

Name ARTESIAN WATER WELLS, INC.
Address 11412 GORDON RD
F. BURG VA 22407
Phone (540) 785-8763

Driller's Signature Wade A. Duffin Jr.
Date 12/13/00 Representing A.W.W.I.

Virginia Contractor's Licence Number 2705-046112