

Seal Well
 Mine Redef #23
 Stafford
 off #655

Drillers Log

Depth


Description of Formation or Sediment

Remarks

0	10	Brown Clay
10	70	Mucaceous formation
70	140	Gray Shale

Set 4" P.V.C. Well Casing
 + Screen - as liner -
 from approx
 150 to 140' due to
 the nature of
 the formation

DIAGRAM (NOT TO SCALE)

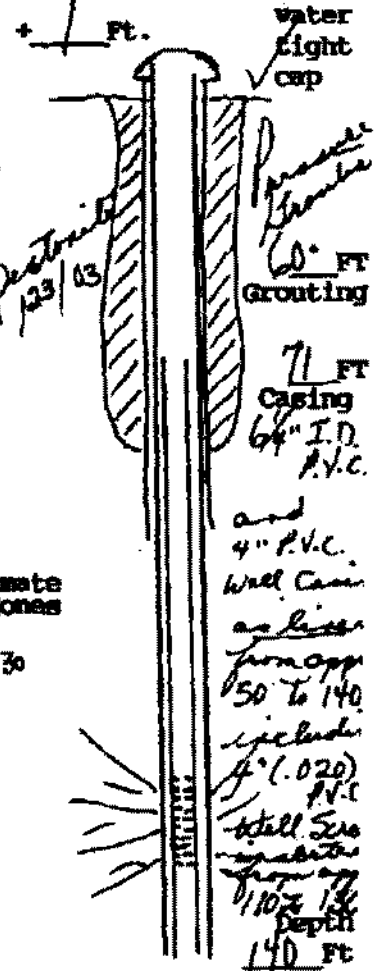

Approximate Water Zones

110 to 130

(Use additional Sheets if necessary)

I certify that the information contained here is true and that this well was installed and constructed in accordance with the permit and further that the well complies with all applicable state and local regulations, ordinances and laws.

Name JOHN L. DANIELSON, JR., INC.
 Address 4516 HOOD DRIVE
FREDERICKSBURG, VIRGINIA 22408
 Phone 540 (703) 898-6025 / 898-9355
 Drillers Signature [Signature]
 Date 1/23/03 representing JOHN L. DANIELSON, JR., INC.
 Virginia Contractors License Number CLASS A 2701 014084A H/H WMC