

Harley  
25 Holly Chase Rd.  
Woodbridge, Va. 22406

Commonwealth of Virginia  
Uniform Water Well Completion Report

Owner Joseph Harley  
Address 12324 Rotary Place  
Woodbridge, Va. 22152  
Phone 1-703-491-4811  
Location 655 off 17 (Near Holly Corner East.)  
183A  
Well Classification IIIA IIIB  IIIC IV  
Approx 1 1/2 M. South of Inter 17 & 655 \* Well Data \*  
" 50' West of 655

Tax Map ID 43-53  
VDH Permit SWP-94-335  
VWCB Permit \_\_\_\_\_  
VWCB ID \_\_\_\_\_  
County Stafford  
7/24/94 Robert Wright

General Information

Drilling Method air rotary Date Completed 11/21/94  
Depth to Bedrock 45 Yield 6 (GPM)  
Static Water Level approx 40 Stabilized Water Level approx 20  
Well Disinfected (Y or N) \_\_\_\_\_ Disinfectant Used \_\_\_\_\_

Total Depth of Well 300'  
Length of Test approx 1 Hr  
Natural Flow (Rate) \_\_\_\_\_  
Amount Used \_\_\_\_\_

Casing

From +1 To 64 From \_\_\_\_\_ To \_\_\_\_\_  
Size 6 3/4" Material P.V.C. Size \_\_\_\_\_ Material \_\_\_\_\_  
Weight/Schedule SDR 27 Weight/Schedule \_\_\_\_\_

Gravel Pack

From \_\_\_\_\_ To \_\_\_\_\_ From \_\_\_\_\_ To \_\_\_\_\_

Hole size

10" from 0 to 64 ft. 6 3/8" from 64 to 300 ft. " from \_\_\_\_\_ to \_\_\_\_\_ ft.

Grout

From 0 To 50' 11/23/94 From \_\_\_\_\_ To \_\_\_\_\_  
Bore Hole Size 10" Bore Hole Size \_\_\_\_\_  
Type Bentonite Type \_\_\_\_\_  
Method Pressure Grouting Method \_\_\_\_\_

Water Zones or Screened Intervals

From 160 To 161 From \_\_\_\_\_ To \_\_\_\_\_  
Mesh Size \_\_\_\_\_ Diam \_\_\_\_\_ Mesh Size \_\_\_\_\_ Diam \_\_\_\_\_  
From 260 To 261 From \_\_\_\_\_ To \_\_\_\_\_  
Mesh Size \_\_\_\_\_ Diam \_\_\_\_\_ Mesh Size \_\_\_\_\_ Diam \_\_\_\_\_

\* Use Data \*

Private Well: Domestic  Agricultural \_\_\_\_\_ Industrial \_\_\_\_\_ Monitoring \_\_\_\_\_  
Public Well: Community \_\_\_\_\_ Non Community \_\_\_\_\_

\* Abandonment Information \*

Bored or Dug Wells

Casing Removed, Y or N? \_\_\_\_\_  
If Y, Depth to which casing was removed: \_\_\_\_\_  
Depth and Type of Fill: \_\_\_\_\_  
Source of Fill \_\_\_\_\_  
Bentonite Plugs: From \_\_\_\_\_ to \_\_\_\_\_ From \_\_\_\_\_ to \_\_\_\_\_

Wells other than Bored Wells

Casing removed, Y or N? \_\_\_\_\_  
Depth to which casing was removed: \_\_\_\_\_  
Applicable, depth(s), and type of gravel/sand fill: \_\_\_\_\_  
Source of gravel or sand: \_\_\_\_\_  
Cement: From \_\_\_\_\_ to \_\_\_\_\_ From \_\_\_\_\_ to \_\_\_\_\_

Method of permanently marking location: \_\_\_\_\_  
Installed watertight top  
Suggest setting pump @ approx 280 ft.


Joseph Harvey  
Stafford #55  
off #17

\* Drillers Log \*

Depth Description of Formation or Sediment Remarks

0	10	Red Clay
10	40	Brown Clay
40	64	Brown Shale (5 ft)
64	300	Light Grey Rock

DIAGRAM  
 (NOT TO SCALE)  
 + 1 Ft.

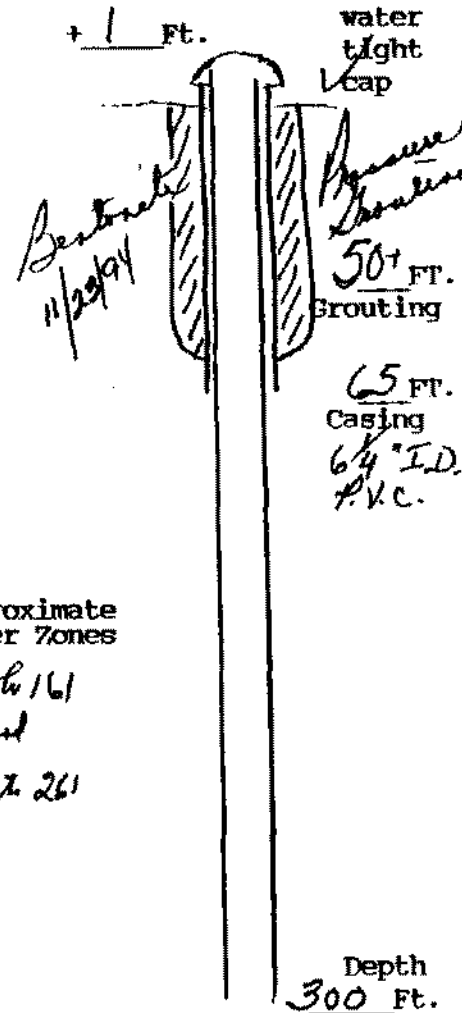

Approximate  
 Water Zones

160 to 161  
 and  
 260 to 261

(Use additional Sheets if necessary)

I certify that the information contained here is true and that this well was installed and constructed in accordance with the permit and further that the well complies with all applicable state and local regulations, ordinances and laws.

Name JOHN L. DANIELSON, JR., INC.  
 Address 4616 HOOD DRIVE  
FREDERICKSBURG, VIRGINIA 22408  
 Phone (703) 898-6025 / 898-9355

Drillers Signature John L. Danielson, Jr.  
 Date 11/23/94 Representing JOHN L. DANIELSON, JR., INC.

Virginia Contractors License Number CLASS A 2701 014084A H/H WWC