

Best Harrison


Richard Vassiliades
Holly Corner Estates #14
Stafford #17 → 255 • Drillers Log •

Department of Health
Virginia
Permit
Company/Contractor

Depth Description of Formation or Sediment Remarks

0	10	Red Clay
10	46	Brown Clay
46	57	Soft Brown Shale
57	70	Brown Shale
70	180	Light Grey Granite

{ set 4" P.V.C. Well casing & screen due to soft area in the formation

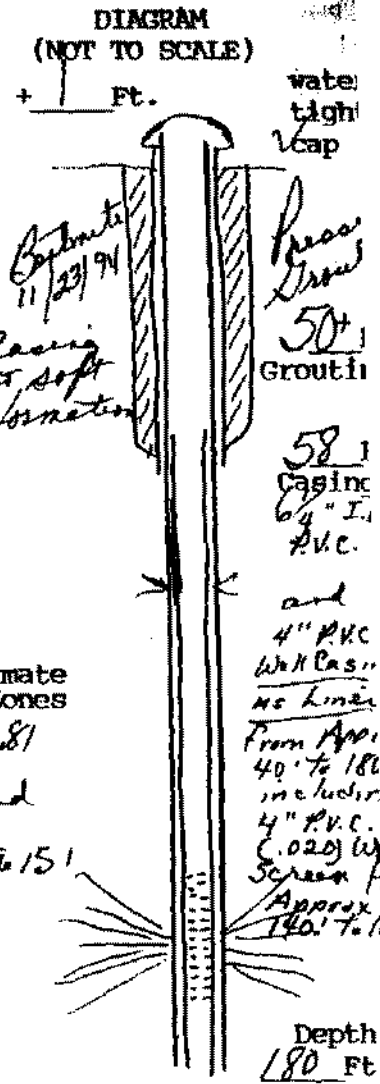

Approximate Water Zones
80281
and
150 to 151

(Use additional Sheets if necessary)

I certify that the information contained here is true and that this well was installed and constructed in accordance with the permit and further that the well complies with all applicable state and local regulations, ordinances and laws.

Name JOHN L. DANIELSON, JR., INC.
Address 4616 HOOD DRIVE
FREDERICKSBURG, VIRGINIA 22408
Phone (703) 898-6025 / 898-9355

Drillers Signature [Signature]
Date 1/23/94 Representing JOHN L. DANIELSON, JR., INC.

Virginia Contractors License Number CLASS A 2701 014084A H/H WVC