

C. Sullivan
24 Richard Jessup Rd
Fredericksburg 22406
752-2860

Commonwealth of Virginia
Uniform Water Well Completion Report

43-33

Owner Lois Roberson
Address 4000 Cathedral Ave. N.W. Apt 234B
Washington D.C. 20016
Phone 202-312-123
Location 654 -> L. on HASSLE LANE on Left.

Tax Map ID 48-1-300
VDH Permit 3WP-95-265
VWCB Permit _____
VWCB ID _____
County STAFFORD
10/27/95 David Jacoby
DJC

Well Classification IIIA _____ IIIB IIIC _____ IV _____
* Well Data *

General Information

Drilling Method Air Rotary
Depth to Bedrock 63
Static Water Level 30
Well Disinfected (Y or N) _____

Date Completed 7/9/96
Yield 30 (GPM)
Stabilized Water Level approx 140
Disinfectant Used _____

Total Depth of Well 300
Length of Test approx 1 Hr.
Natural Flow (Rate) _____
Amount Used _____

Casing From +1 To 82
Size 6 1/4 Material P.V.C.
Weight/Schedule SDR 27

From 60 To 260
Size 4" Material P.V.C.
Weight/Schedule Sch 40

From 280 To 300
Size 4" Material P.V.C.
Weight/Schedule Sch 40

Gravel Pack

From _____ To _____
Hole size 10" from 0 to 50 ft.
Grout From 0 To 50'
Bore Hole Size 10" 7/9/96
Type Bentonite
Method Treasure Troung

From _____ To _____
7 7/8" from 50 to 82 ft.
From _____ To _____
Bore Hole Size _____
Type _____
Method _____

From _____ To _____
6 1/8" from 82 to 300 ft.
From _____ To _____
Bore Hole Size _____
Type _____
Method _____

Water Zones or Screened Intervals

From 260 To 280
Mesh Size 0.20 Diam 4" (P.V.C.)
From _____ To _____
Mesh Size _____ Diam _____

From 160 To 161
Mesh Size _____ Diam _____
From 270 To 271
Mesh Size _____ Diam _____

From _____ To _____
Mesh Size _____ Diam _____
From _____ To _____
Mesh Size _____ Diam _____

* Use Data *

Private Well: Domestic Agricultural _____ Industrial _____ Monitoring _____
Public Well: Community _____ Non Community _____

* Abandonment Information *

Bored or Dug Wells

Casing Removed, Y or N? _____
If Y, Depth to which casing was removed: _____
Depth and Type of Fill: _____
Source of Fill: _____
Bentonite Plugs: From _____ to _____ From _____ to _____

Wells other than Bored Wells

Casing removed, Y or N? _____
Depth to which casing was removed: _____
Applicable, depth(s), and type of gravel/sand fill: _____
Source of gravel or sand: _____
Cement: From _____ to _____ From _____ to _____

Method of permanently marking location: _____
 Installed watertight top
Suggest setting pump @ approx. 160 ft.

150 C. O. D. G. R. Box 781


George Sullivan
Lois Roberson
Hazak Rd off 654
Stafford

• Drillers Log •

Depth	Description of Formation or Sediment	Remarks
0	10	Red Clay
10	65	Brown Clay
65	130	Brown Shale
130	170	Grey Shale
170	210	Brown Shale
210	300	Grey Shale



DIAGRAM (NOT TO SCALE)

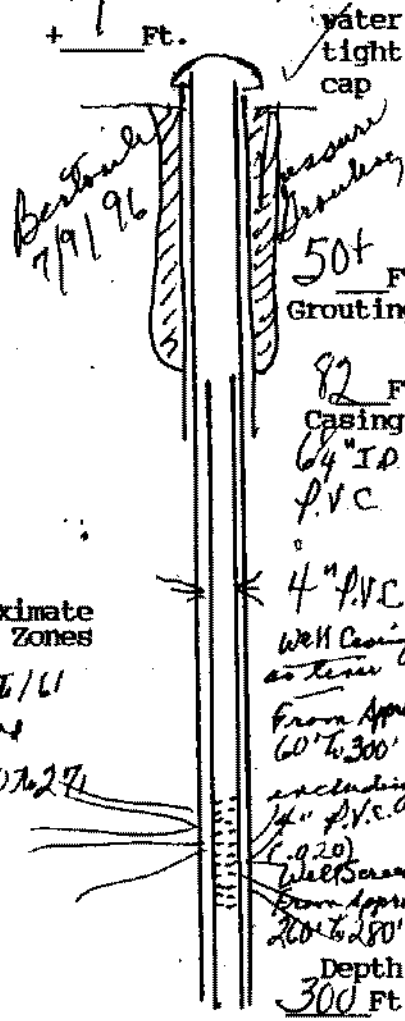

Approximate Water Zones
160 to 171
and
270 to 271

(User additional Sheets if necessary)

I certify that the information contained here is true and that this well was installed and constructed in accordance with the permit and further that the well complies with all applicable state and local regulations, ordinances and laws.

Name JOHN L. DANIELSON, JR., INC.
 Address 4616 HOOD DRIVE
FREDERICKSBURG, VIRGINIA 22408
 Phone 540 (703) 898-6025 / 898-9355

Drillers Signature John L. Danielson Pres.
 Date 7/9/96 Representing JOHN L. DANIELSON, JR., INC.

Virginia Contractors License Number CLASS A 2701 014084A H/H WWC