

Commonwealth of Virginia

Uniform Water Well Completion Report

Landmark Homes
P.O. Box 3434
Fredericksburg VA 22403
286-0042 F 286-0371
Owner Rick Loy 1 For Sale
Address 481 Holly Berry
2 burg 22406
Phone 752-0520 -- 286-0042
Location # 655 Holly Corner Est. 13

Tax Map ID 43C-1-13
VDH Permit SWP-96-159
VWCB Permit
VWCB ID
County Stafford
Rob Sypden
SFF

Well Classification IIIA ___ IIIB IIIC ___ IV ___
* Well Data *

General Information

Drilling Method Air Rotary
Depth to Bedrock 60'
Static Water Level 60'
Well Disinfected (Y or N)
Date Completed 12/24/97
Yield 20 (GPM)
Stabilized Water Level 80'
Disinfectant Used

Total Depth of Well 200'
Length of Test approx 1 hr.
Natural Flow (Rate)
Amount Used

Casing

From +1 To 60
Size 1 1/4 Material PVC
Weight/Schedule S.D.R. 27
From ___ To ___
Size ___ Material ___
Weight/Schedule ___

Gravel Pack

From ___ To ___
Hole size 10" From 0 to 55 ft.
Grout 7/8" From 55 to 60 ft. 6/8" From 60 to 200 ft.
From 0 To 50' 12/24/97
Bore Hole Size 10"
Type Bentonite
Method Pressure Grouting

Water Zones or Screened Intervals

From 189 To 190
Mesh Size ___ Diam ___
From ___ To ___
Mesh Size ___ Diam ___

* Use Data *

Private Well: Domestic Agricultural ___ Industrial ___ Monitoring ___
Public Well: Community ___ Non Community ___

* Abandonment Information *


Bored or Dug Wells
Casing Removed, Y or N? ___
If Y, Depth to which casing was removed: ___
Depth and Type of Fill: ___
Source of Fill ___
Bentonite Plugs: From ___ to ___ From ___ to ___
Wells other than Bored Wells
Casing removed, Y or N? ___
Depth to which casing was removed: ___
Applicable, depth(s), and type of gravel/sand fill: ___
Source of gravel or sand: ___
Cement: From ___ to ___ From ___ to ___
Method of permanently marking location:
 Installed watertight top
Suggest setting pump @ approx. 100 ft.

Rick Low
 Heartland Homes
 Holly Corner Est #13
 Stafford
 655

* Drillers Log *

Depth Description of Formation or Sediment Remarks

0	10	Red Clay
10	30	Micaceous formation / Red
30	50	Micaceous formation / Brown
50	60	Brown Shale
60	200	Blue Granite

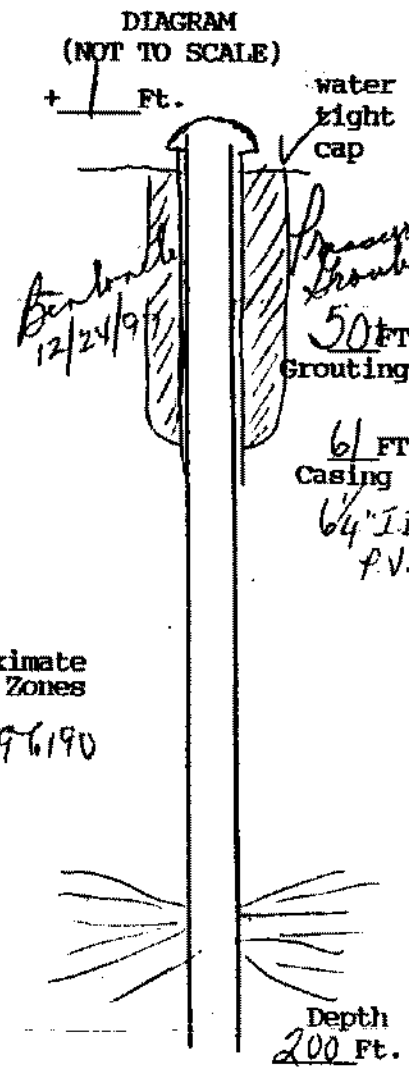

Approximate
 Water Zones
 1896190

(User additional Sheets if necessary)

I certify that the information contained here is true and that this well was installed and constructed in accordance with the permit and further that the well complies with all applicable state and local regulations, ordinances and laws.

Name JOHN L. DANIELSON, JR., INC.
 Address 4616 HOOD DRIVE
FREDERICKSBURG, VIRGINIA 22408
 Phone 540 (208) 898-6025 / 898-9355

Drillers Signature *John L. Danielson, Jr.*
 Date 12/24/97 Representing JOHN L. DANIELSON, JR., INC.

Virginia Contractors License Number CLASS A 2701 014084A II/H WVC