

Home Address  
 Childress Jones  
 P.O. Box 733  
 Fredericksburg, Va 22404  
 785-0086 F 785-02292

Commonwealth of Virginia  
 Uniform Water Well Completion Report

Owner David W. Ryder  
 Address 15 Walnut Hill Lane  
Fredericksburg, Va. 22405  
 Phone 791-2201  
 Location 17 -> 655 Drive Way (Just Past Old Farm Rd  
Just before Westhollow Lane 7/8/96

Tax Map ID 43-117  
 VDH Permit SWP-96-32  
 VWCB Permit \_\_\_\_\_  
 VWCB ID \_\_\_\_\_  
 County STAFFORD  
Special Precinct  
 \* Well Data \*  
SFF

Well Classification IIIA \_\_\_\_\_ IIIB  IIIC \_\_\_\_\_ IV \_\_\_\_\_

General Information  
 Drilling Method Aug Rotary  
 Depth to Bedrock 80'  
 Static Water Level 30'  
 Well Disinfected (Y or N) \_\_\_\_\_

Date Completed 11/14/96  
 Yield 8 (GPM)  
 Stabilized Water Level 180'  
 Disinfectant Used \_\_\_\_\_

Total Depth of Well 240'  
 Length of Test approx 1 Hr  
 Natural Flow (Rate) \_\_\_\_\_  
 Amount Used \_\_\_\_\_

Casing  
 From +1 To 105  
 Size 6 1/2" Material P.V.C.  
 Weight/Schedule SDR 27

From 100 To 200  
 Size 4" Material P.V.C.  
 Weight/Schedule Sch 40

From 220 To 240  
 Size 4" Material P.V.C.  
 Weight/Schedule Sch 40

Gravel Pack  
 From \_\_\_\_\_ To \_\_\_\_\_

From \_\_\_\_\_ To \_\_\_\_\_

From \_\_\_\_\_ To \_\_\_\_\_

Hole size  
10" from 0 to 60 ft.  
 Grout  
 From 0 To 50'  
 Bore Hole Size 10" 11/15/96  
 Type Bentonite  
 Method Pressure Grouting

7 7/8" from 60 to 105 ft.  
 From \_\_\_\_\_ To \_\_\_\_\_  
 Bore Hole Size \_\_\_\_\_  
 Type \_\_\_\_\_  
 Method \_\_\_\_\_

6 1/2" from 105 to 240 ft.  
 From \_\_\_\_\_ To \_\_\_\_\_  
 Bore Hole Size \_\_\_\_\_  
 Type \_\_\_\_\_  
 Method \_\_\_\_\_

Water Zones or Screened Intervals  
 From 200 To 220  
 Mesh Size .020 Diam 4" (P.V.C.)  
 From \_\_\_\_\_ To \_\_\_\_\_  
 Mesh Size \_\_\_\_\_ Diam \_\_\_\_\_

From 207 To 208  
 Mesh Size \_\_\_\_\_ Diam \_\_\_\_\_  
 From \_\_\_\_\_ To \_\_\_\_\_  
 Mesh Size \_\_\_\_\_ Diam \_\_\_\_\_

From \_\_\_\_\_ To \_\_\_\_\_  
 Mesh Size \_\_\_\_\_ Diam \_\_\_\_\_  
 From \_\_\_\_\_ To \_\_\_\_\_  
 Mesh Size \_\_\_\_\_ Diam \_\_\_\_\_

\* Use Data \*

Private Well: Domestic  Agricultural \_\_\_\_\_ Industrial \_\_\_\_\_ Monitoring \_\_\_\_\_  
 Public Well: Community \_\_\_\_\_ Non Community \_\_\_\_\_

\* Abandonment Information \*

Bored or Dug Wells  
 Casing Removed, Y or N?: \_\_\_\_\_  
 If Y, Depth to which casing was removed: \_\_\_\_\_  
 Depth and Type of Fill: \_\_\_\_\_  
 Source of Fill \_\_\_\_\_  
 Bentonite Plugs: From \_\_\_\_\_ to \_\_\_\_\_ From \_\_\_\_\_ to \_\_\_\_\_

Wells other than Bored Wells  
 Casing removed, Y or N? \_\_\_\_\_  
 Depth to which casing was removed: \_\_\_\_\_  
 Applicable, depth(s), and type of gravel/sand fill: \_\_\_\_\_  
 Source of gravel or sand: \_\_\_\_\_  
 Cement: From \_\_\_\_\_ to \_\_\_\_\_ From \_\_\_\_\_ to \_\_\_\_\_

Method of permanently marking location:  
 Installed watertight top  
 Suggest setting pump @ approx. 200 ft.  
guy will encounter 4" P.V.C. @ approx 100 FT.  
it bears a resemblance to those arrestors


Address  
 Wood Hyde  
 Stafford

17-5655 Drive way just past Old Farm Rd just before  
 Driller's Log create the Drive

Depth Description of Formation or Sediment Remarks

0	10	Red Clay
10	30	Micaceous formation / Red
30	70	Micaceous formation / Brown
70	106	Brown Shale
106	240	Blue Shale

set 4" P.V.C. Well Casing  
 & screen - no liner -  
 due to the softness  
 of the formation

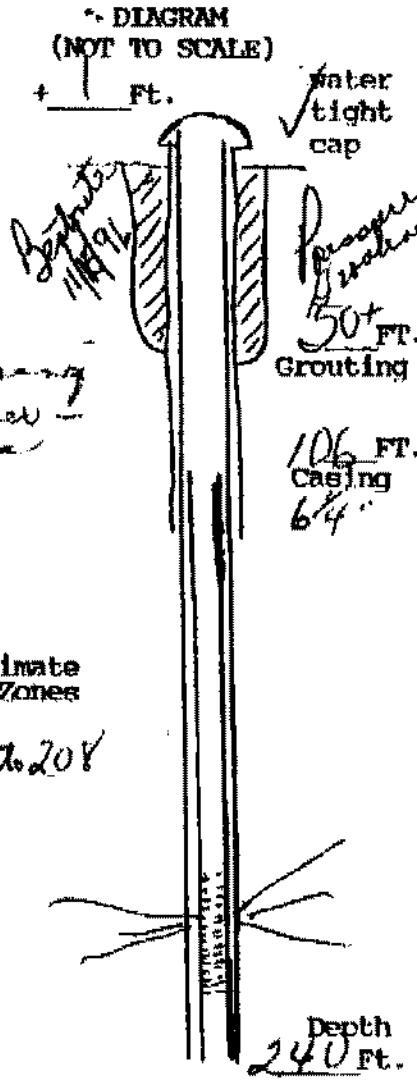

(Use additional Sheets if necessary)

I certify that the information contained here is true and that this well was installed and constructed in accordance with the permit and further that the well complies with all applicable state and local regulations, ordinances and laws.

Name JOHN L. DANIELSON, JR., INC.  
 Address 4616 IKOD DRIVE  
FREDERICKSBURG, VIRGINIA 22408  
 Phone 898-6025 / 898-9355

Drillers Signature John L. Danielson, Jr.  
 Date 11/15/96 Representing JOHN L. DANIELSON, JR., INC.

Virginia Contractors License Number CLASS A 2701 014084A II/II WMC