

Commonwealth of Virginia
Uniform Water Well Completion Report

Lay
Lay Water uses
P.O. Box 5234
Fredericksburg Va 22403
286-0427 Fax 286-0391

Owner Cater Treston
Address 481 Holly Berry Drive
Stafford, Va
Phone 11657-7187
Location Holly Corner East Sect 2 Lot 16
183C

Tax Map ID 43C-2-16
VDH Permit SWP-96-335
VWCB Permit 355
VWCB ID _____
County Stafford
1/10/97 Daniel J. ...
DJC

Well Classification IIIA _____ IIIB IIIC _____ IV _____
Approx 2 M. South of Lot 17/655 * Well Data *
3/0 M. W. of 655

General Information
Drilling Method Air Rotary Date Completed 3/5/97 Total Depth of Well 260'
Depth to Bedrock 45' Yield 30 (GPM) Length of Test _____
Static Water Level 30 Stabilized Water Level 120 Natural Flow (Rate) _____
Well Disinfected (Y or N) _____ Disinfectant Used _____ Amount Used _____

Casing
From 76 To 76 From 60 To 220 From 240 To 260
Size 6 1/4 Material P.V.C. Size 4" Material P.V.C. Size 4" Material P.V.C.
Weight/Schedule S.D.R. 27 Weight/Schedule Sch 40 Weight/Schedule Sch 40

Gravel Pack
From _____ To _____ From _____ To _____ From _____ To _____
Hole size 10" from 0 to 50ft. 7 7/8" from 50 to 76ft. 6 1/8" from 76 to 200ft.
Grout
From 0 To 50+ From _____ To _____ From _____ To _____
Bore Hole Size 10" Bore Hole Size _____ Bore Hole Size _____
Type Exploratory Type _____ Type _____
Method Tremie Shrouding Method _____ Method _____

Water Zones or Screened Intervals
From 220 To 240 From 160 To 161 From _____ To _____
Mesh Size .020 Diam 4" (P.V.C.) Mesh Size _____ Diam _____ Mesh Size _____ Diam _____
From _____ To _____ From 230 To 231 From _____ To _____
Mesh Size _____ Diam _____ Mesh Size _____ Diam _____ Mesh Size _____ Diam _____

* Use Data *

Private Well: Domestic Agricultural _____ Industrial _____ Monitoring _____
Public Well: Community _____ Non Community _____

* Abandonment Information *

Bored or Dug Wells
Casing Removed, Y or N?: _____
If Y, Depth to which casing was removed: _____
Depth and Type of Fill: _____
Source of Fill _____
Bentonite Plugs: From _____ to _____ From _____ to _____

Wells other than Bored Wells
Casing removed, Y or N? _____
Depth to which casing was removed: _____
Applicable, depth(s), and type of gravel/sand fill: _____
Source of gravel or sand: _____
Cement: From _____ to _____ From _____ to _____

Method of permanently marking location:
 Installed watertight top
Suggest setting pump @ approx. 140 ft.
You will encounter 4" casing @ approx 60 ft.
Suggest keeping centralizers & torque arrestors out of 4" casing

Nick Loy
Log Petersburg
Holly Corner Estate # 16 - Lake Herndon
Stafford
4/17/97

* Drillers Log *


Depth Description of Formation or Sediment Remarks

0	10	Red Clay
10	45	Brown Clay
45	76	Brown Shale
76	260	Grey Shale

set 4" P.V.C. Well Casing
 & screen due to
 the softness of
 the formation



DIAGRAM (NOT TO SCALE)

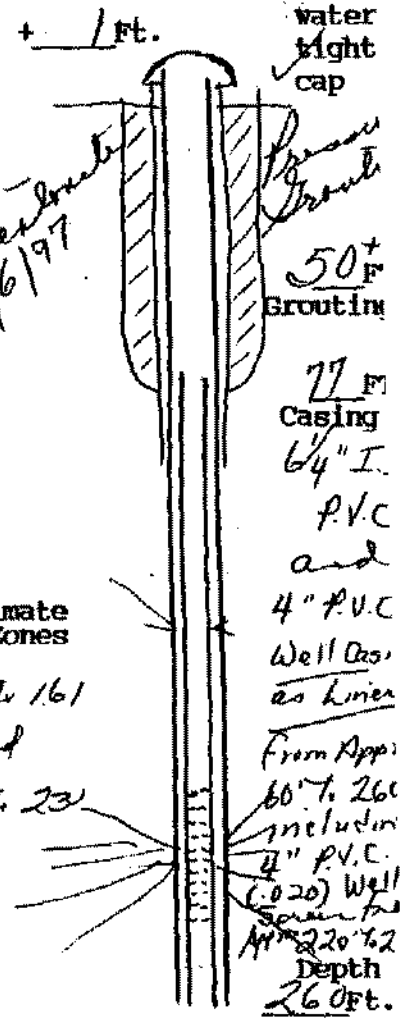

(User additional Sheets if necessary)

I certify that the information contained here is true and that this well was installed and constructed in accordance with the permit and further that the well complies with all applicable state and local regulations, ordinances and laws.

Name JOHN L. DANIELSON, JR., INC.
 Address 4616 HOOD DRIVE
FREDERICKSBURG, VIRGINIA 22408
 Phone 540 (203) 898-6025 / 898-9355

Drillers Signature *John L. Danielson, President*
 Date 3/6/97 Representing JOHN L. DANIELSON, JR., INC.

Virginia Contractors License Number CLASS A 2701 0140B4A H/H WVC