

Commonwealth of Virginia
Uniform Water Well Completion Report

Owner Robert Harrison
Address 711 Holly Corner Road
Fredericksburg, Va. 22406
Phone 752-2602
Location Holly Corner Estates/Sect I/Lot 18 (Holly Bern)

Tax Map ID 43C-2-18
VDH Permit SWP-96-60
VWCB Permit _____
VWCB ID _____
County STAFFORD
3/29/96 Daniel J. Gault Jr
DJC

Well Classification IIIA _____ IIIB IIIC _____ IV _____
* Well Data *

General Information

Drilling Method Air Rotary Date Completed 4/26/96 Total Depth of Well 160'
Depth to Bedrock 65' Yield 40 (GPM) Length of Test approx. 1 Hr
Static Water Level 30' Stabilized Water Level 30' Natural Flow (Rate) _____
Well Disinfected (Y or N) _____ Disinfectant Used _____ Amount Used _____

Casing

| | | |
|--|---------------------------------------|---------------------------------------|
| From <u>+1</u> To <u>81</u> | From <u>60</u> To <u>120</u> | From <u>140</u> To <u>160</u> |
| Size <u>6 1/4</u> Material <u>P.V.C.</u> | Size <u>4"</u> Material <u>P.V.C.</u> | Size <u>4"</u> Material <u>P.V.C.</u> |
| Weight/Schedule <u>SDR 27</u> | Weight/Schedule <u>Sch. 40</u> | Weight/Schedule <u>Sch. 40</u> |

Gravel Pack

From _____ To _____ From _____ To _____ From _____ To _____

Hole size

10" from 0 to 50 ft. 7 1/8" from 50 to 81 ft. 6 1/8" from 81 to 160 ft.

Grout

From 0 To 50' From _____ To _____ From _____ To _____

Bore Hole Size 10" Bore Hole Size _____ Bore Hole Size _____

Type Bentonite Type _____ Type _____

Method Pressure Grouting Method _____ Method _____

Water Zones or Screened Intervals

From 100 To 101 From 120 To 140 From _____ To _____

Mesh Size _____ Diam _____ Mesh Size .020 Diam 4" (P.V.C.) Mesh Size _____ Diam _____

From 130 To 131 From _____ To _____ From _____ To _____

Mesh Size _____ Diam _____ Mesh Size _____ Diam _____ Mesh Size _____ Diam _____

* Use Data *

Private Well: Domestic Agricultural _____ Industrial _____ Monitoring _____
Public Well: Community _____ Non Community _____

* Abandonment Information *

Bored or Dug Wells

Casing Removed, Y or N? _____
If Y, Depth to which casing was removed: _____
Depth and Type of Fill: _____
Source of Fill _____
Bentonite Plugs: From _____ to _____ From _____ to _____

Wells other than Bored Wells

Casing removed, Y or N? _____
Depth to which casing was removed: _____
Applicable, depth(s), and type of gravel/sand fill: _____
Source of gravel or sand: _____
Cement: From _____ to _____ From _____ to _____

Method of permanently marking location: _____
 Installed watertight top
Suggest setting pump @ approx. 100 ft.

Rick Butchyard

Robert Harrison

Holly Corner Est #18

Stafford

Holly Berry - # 655 Drillers Log # 17

STATE DEPARTMENT OF HEALTH
ENVIRONMENTAL HEALTH


Depth

Description of Formation or Sediment

Remarks

| | | |
|-----|-----|-------------|
| 0 | 10 | Red Clay |
| 10 | 65 | Brown Clay |
| 65 | 81 | Brown Shale |
| 81 | 90 | Grey Shale |
| 90 | 105 | Brown Shale |
| 105 | 160 | Grey Shale |

set 4" P.V.C. Well Screen
& Well Casing due
to the softness
of the formation

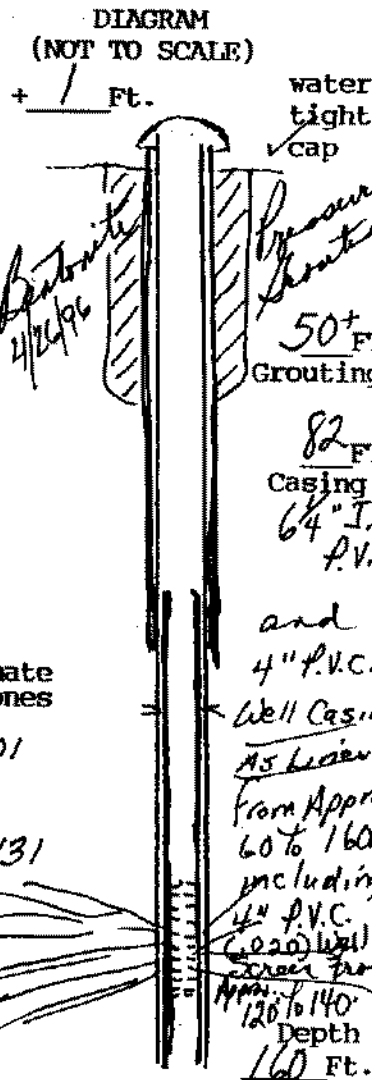

Approximate Water Zones

100% 101

and

130% 131



(User additional Sheets if necessary)

I certify that the information contained here is true and that this well was installed and constructed in accordance with the permit and further that the well complies with all applicable state and local regulations, ordinances and laws.

Name JOHN L. DANIELSON, JR., INC.

Address 4616 HOOD DRIVE

FREDERICKSBURG, VIRGINIA 22408

Phone 540 (703) 898-6025 / 898-9355

Drillers Signature

Date 4/26/96 Representing JOHN L. DANIELSON, JR., INC.

Virginia Contractors License Number CLASS A 2701 014084A H/II WVC