

**Commonwealth of Virginia
Uniform Water Well Completion Report**

Owner Hubert & Deborah DuVal Jr
 Address 5932 Langston
Alexandria Va.
 Phone 703-971-4458 Fax 703-971-8338
 Location Mane Ridge Sect 3 - lot 25 (off 655)

Tax Map ID 43A-3-25
 VDH Permit SWP-98-217
 VWCB Permit _____
 VWCB ID _____
 County Stafford
6/10/99 Rob Snyder

Well Classification IIIA _____ IIIB IIIC _____ IV _____
 * Well Data *

DIC

General Information

Drilling Method Air Rotary
 Depth to Bedrock 45
 Static Water Level 30
 Well-Disinfected (Y or N) _____

Date Completed 8/19/99
 Yield 60 (GPM)
 Stabilized Water Level 80
 Disinfectant Used _____

Total Depth of Well 240
 Length of Test approx 1 Hr
 Natural Flow (Rate) _____
 Amount Used _____

Casing

From 1 To 66
 Size 6 1/2 Material PVC
 Weight/Schedule SDR 27

From _____ To _____
 Size _____ Material _____
 Weight/Schedule _____

From _____ To _____
 Size _____ Material _____
 Weight/Schedule _____

Gravel Pack

From _____ To _____

From _____ To _____

From _____ To _____

Hole size 10" from 0 to 50 ft.

7 1/2" from 50 to 66 ft.

6 1/2" from 66 to 240 ft.

Grout From 0 To 50

From _____ To _____

From _____ To _____

Bore Hole Size 10"

Bore Hole Size _____

Bore Hole Size _____

Type Bentonite

Type _____

Type _____

Method Pressure Grouting

Method _____

Method _____

Water Zones or Screened Intervals

From 120 To 121

From _____ To _____

From _____ To _____

Mesh Size _____ Diam _____

Mesh Size _____ Diam _____

Mesh Size _____ Diam _____

From 220 To 221

From _____ To _____

From _____ To _____

Mesh Size _____ Diam _____

Mesh Size _____ Diam _____

Mesh Size _____ Diam _____

*** Use Data ***

Private Well: Domestic Agricultural _____ Industrial _____ Monitoring _____
 Public Well: Community _____ Non Community _____

*** Abandonment Information ***

Bored or Dug Wells

Casing Removed, Y or N? _____
 If Y, Depth to which casing was removed: _____
 Depth and Type of Fill: _____
 Source of Fill _____
 Bentonite Plugs: From _____ to _____ From _____ to _____

Wells other than Bored Wells

Casing removed, Y or N? _____
 Depth to which casing was removed: _____
 Applicable, depth(s), and type of gravel/sand fill: _____
 Source of gravel or sand: _____
 Cement: From _____ to _____ From _____ to _____

Method of permanently marking location: _____


Installed watertight top
 Suggest setting pump @ approx. 100 ft.

Albert & Deborah Duval Jr.
Mass Ridge #25
Stafford
 off #655

* Drillers Log *

Depth Description of Formation or Sediment Remarks

0	10	Red Clay
10	45	Meacrus formation / Brown
45	110	Brown Shale
110	240	Grey Granite

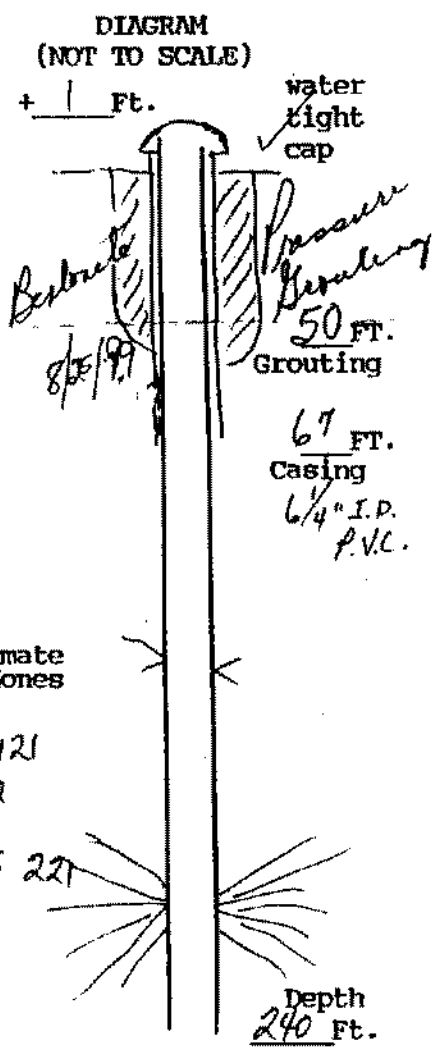

Approximate Water Zones

120' ± 121'
 and
 220' ± 221'

(Use additional Sheets if necessary)

I certify that the information contained here is true and that this well was installed and constructed in accordance with the permit and further that the well complies with all applicable state and local regulations, ordinances and laws.

Name JOHN L. DANIELSON, JR., INC.
 Address 4616 HOOD DRIVE
FREDERICKSBURG, VIRGINIA 22408
 Phone (703) 898-6025 / 898-9355

Drillers Signature John L. Danielson, Pres.
 Date 9/25/99 Representing JOHN L. DANIELSON, JR., INC.

Virginia Contractors License Number CLASS A 2701 014084A H/H WVC