

**Commonwealth of Virginia
Uniform Water Well Completion Report**

Owner Rick Lox
 Address 501 Hollyburg Road
Stafford, Va.
 Phone 752-0520
 Location Holly Brook Estates #29 (Sec 20)

Tax Map ID 43C-2-24
 VDH Permit WR95-24
 VWCB Permit _____
 VWCB ID _____
 County STAFFORD
1465 Dan Jacoby

Well Classification IIIA IIIB IIIC IV
 * Well Data *

General Information

Drilling Method Air Rotary
 Depth to Bedrock 3.5'
 Static Water Level approx 30'
 Well Disinfected (Y or N) _____

Date Completed 1/28/95
 Yield 2.2 (GPM)
 Stabilized Water Level approx 340
 Disinfectant Used _____

Total Depth of Well 400
 Length of Test approx 1 Hr
 Natural Flow (Rate) _____
 Amount Used _____

Casing

From +1 to 55
 Size 6 1/4 Material P.V.C.
 Weight/Schedule SDR 27

From 40 to 240
 Size 4" Material P.V.C.
 Weight/Schedule Sch 40

From 260' to 360'
 To 360' and 400'
 Size 4" Material P.V.C.
 Weight/Schedule Sch 40

Gravel Pack

From _____ To _____

From _____ To _____

From _____ To _____

Hole size

10" from 0 to 56 ft.

6 1/8" from 56 to 400 ft.

" from _____ to _____ ft.

Grout

From 0 to 50'
 Bore Hole Size 10"
 Type Bentonite
 Method Pressure Grouting

From _____ To _____

From _____ To _____

Water Zones or Screened Intervals

From 240 to 260
 Mesh Size .020 Diam 4" (P.V.C.)
 From _____ To _____
 Mesh Size _____ Diam _____

From 360 to 380
 Mesh Size .020 Diam 4" (P.V.C.)
 From _____ To _____
 Mesh Size _____ Diam _____

From 200 to 201
 Mesh Size _____ Diam _____
 From 320 to 321
 Mesh Size _____ Diam _____

*** Use Data ***

Private Well: Domestic Agricultural _____ Industrial _____ Monitoring _____
 Public Well: Community _____ Non Community _____

*** Abandonment Information ***

Bored or Dug Wells

Casing Removed, Y or N? _____
 If Y, Depth to which casing was removed: _____
 Depth and Type of Fill: _____
 Source of Fill: _____
 Bentonite Plugs: From _____ to _____ From _____ to _____

Wells other than Bored Wells

Casing removed, Y or N? _____
 Depth to which casing was removed: _____
 Applicable, depth(s), and type of gravel/sand fill: _____
 Source of gravel or sand: _____
 Cement: From _____ to _____ From _____ to _____

Method of permanently marking location:


Installed watertight top
 Suggest setting pump @ approx. 360 ft.

You will encounter 4" casing @ approx 40'
Suggest keeping torque wrenches & centralizers out of 4" ca

Drillers Log
Woods Corner Estates # 24
Stafford
 #655 - 501 Holly Berry Rd.
 * Drillers Log *

Depth	Description of Formation or Sediment	Remarks
0	10	Red Clay
10	35	Brown Clay
35	220	Dark Grey Rock
220	340	Light Grey Rock
340	400	Dark Grey Rock

Set 4" P.V.C. Casings screen due to the softness of the formation

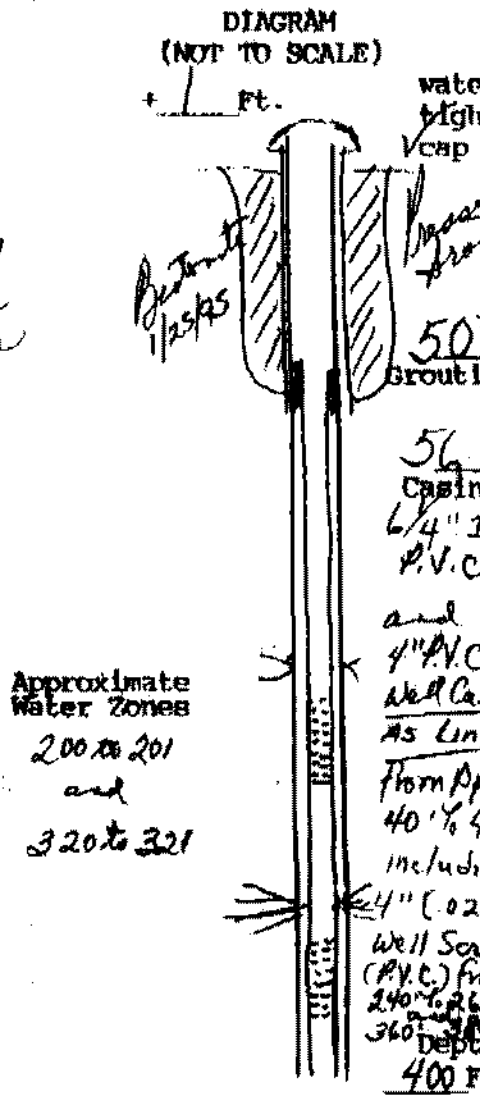

(User additional Sheets if necessary)

I certify that the information contained here is true and that this well was installed and constructed in accordance with the permit and further that the well complies with all applicable state and local regulations, ordinances and laws.

Name JOHN L. DANIELSON, JR., INC.
 Address 4616 HOOD DRIVE
FREDERICKSBURG, VIRGINIA 22408
 Phone (703) 898-6025 / 898-9355

Drillers Signature [Signature]
 Date 2/3/75 Representing JOHN L. DANIELSON, JR., INC.

Virginia Contractors License Number CLASS A 2701 014084A H/H WMC