

Construction Shop

22402 22408 Commonwealth of Virginia  
6784 ct. Uniform Water Well Completion Report  
FAX 978-5219

Owner George S. Hare  
Address 12809 Frontier Court  
Woodbridge, Va. 590-4482  
Phone \_\_\_\_\_  
Location Holly Corner Plat Sect 2 Lot 20  
approx 3/4 M. North of Holly Corner Rd.  
Well Classification IIIA  IIIB  IIIC  IV

Tax Map ID 43C-2-20  
VDH Permit WS-91-210  
VWCB Permit \_\_\_\_\_  
VWCB ID \_\_\_\_\_  
County STAFFORD  
10/3/91 Karl Rudolph  
10/15/91 J. J. Thompson

\* Well Data \*

General Information

Drilling Method Air Rotary Date Completed 3/31/94  
Depth to Bedrock 68 Yield 12 (GPM)  
Static Water Level 40' Stabilized Water Level 160  
Well Disinfected (Y or N) \_\_\_\_\_ Disinfectant Used \_\_\_\_\_

Total Depth of Well 200  
Length of Test approx 1 Hr.  
Natural Flow (Rate) \_\_\_\_\_  
Amount Used \_\_\_\_\_

Casing

From +1 To 68  
Size 6 1/2" Material PVC  
Weight/Schedule SDR 27

From \_\_\_\_\_ To \_\_\_\_\_  
Size \_\_\_\_\_ Material \_\_\_\_\_  
Weight/Schedule \_\_\_\_\_

Gravel Pack

From \_\_\_\_\_ To \_\_\_\_\_

From \_\_\_\_\_ To \_\_\_\_\_

Hole size

10" from 0 to 65 ft.

6 1/2" from 68 to 200 ft.

GROUT

From 0 To 65 ft. / 4/1/94  
Bore Hole Size 10"  
Type Bentonite  
Method Pressure Grouting

From \_\_\_\_\_ To \_\_\_\_\_  
Bore Hole Size \_\_\_\_\_  
Type \_\_\_\_\_  
Method \_\_\_\_\_

Water Zones or Screened Intervals

From 182 To 183  
Mesh Size \_\_\_\_\_ Diam \_\_\_\_\_  
From \_\_\_\_\_ To \_\_\_\_\_  
Mesh Size \_\_\_\_\_ Diam \_\_\_\_\_

From \_\_\_\_\_ To \_\_\_\_\_  
Mesh Size \_\_\_\_\_ Diam \_\_\_\_\_  
From \_\_\_\_\_ To \_\_\_\_\_  
Mesh Size \_\_\_\_\_ Diam \_\_\_\_\_

\* Use Data \*

Private Well: Domestic  Agricultural \_\_\_\_\_ Industrial \_\_\_\_\_ Monitoring \_\_\_\_\_  
Public Well: Community \_\_\_\_\_ Non Community \_\_\_\_\_

\* Abandonment Information \*

Bored or Dug Wells

Casing Removed, Y or N? \_\_\_\_\_  
If Y, Depth to which casing was removed: \_\_\_\_\_  
Depth and Type of Fill: \_\_\_\_\_  
Source of Fill \_\_\_\_\_  
Bentonite Plugs: From \_\_\_\_\_ to \_\_\_\_\_ From \_\_\_\_\_ to \_\_\_\_\_

Wells other than Bored Wells

Casing removed, Y or N? \_\_\_\_\_  
Depth to which casing was removed: \_\_\_\_\_  
Applicable, depth(s), and type of gravel/sand fill: \_\_\_\_\_  
Source of gravel or sand: \_\_\_\_\_  
Cement: From \_\_\_\_\_ to \_\_\_\_\_ From \_\_\_\_\_ to \_\_\_\_\_


Method of permanently marking location: \_\_\_\_\_

Installed watertight top  
Suggest setting pump @ approx. 180 ft.


John Patrick Hand Construction  
Holly Corners Estates #20  
Stafford off 655 #17

\* Drillers Log \*

Depth	Description of Formation or Sediment	Remarks
0	10	Red Clay
10	35	Micaceous formation/Red
35	50	Micaceous formation/Brown
50	65	Brown Shale
65	200	Blue Granite

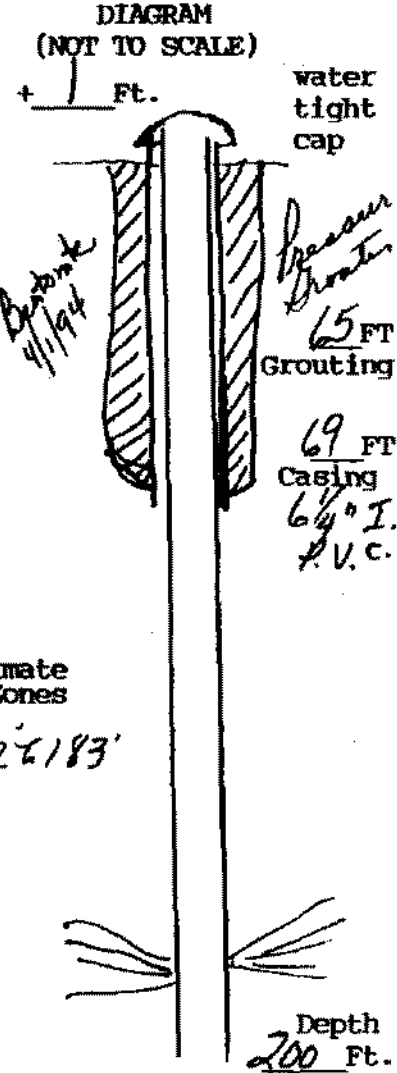

Approximate  
Water Zones  
182' & 183'

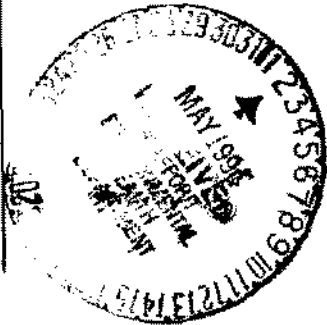

(User additional Sheets if necessary)

I certify that the information contained here is true and that this well was installed and constructed in accordance with the permit and further that the well complies with all applicable state and local regulations, ordinances and laws.

Name JOHN L. DANIELSON, JR., INC.  
 Address 4616 HOOD DRIVE  
FREDERICKSBURG, VIRGINIA 22408  
 Phone (703) 898-6025 / 898-9355

Drillers Signature *John L. Danielson, Pres.*  
 Date 4/1/94 Representing JOHN L. DANIELSON, JR., INC.

Virginia Contractors License Number CLASS A 2701 014084A H/H WVC