

Thompson Building Corp.
Box 615
Bedford, Va. 22404
785-0298 Fax 785-0634

Commonwealth of Virginia
Uniform Water Well Completion Report

Owner Thompson Building Corp. / For Sale
Address PO Box 615
Bedford, Virginia 22404
Phone 785-0298
Location Staley Corners # 8 (Holly Berry Road)
2 M. South of 654 & 655 / .3 M. W. E. of 655
Well Classification IIIA IIIB IIIC IV
183D * Well Data *

Tax Map ID ? 43 c-1-8?
VDH Permit WS-92-408
VWCB Permit _____
VWCB ID _____
County Stafford
1-5-93 David Vandy
1-6-93 J.J. Thompson

General Information

Drilling Method Air Rotary
Depth to Bedrock 45
Static Water Level 40
Well Disinfected (Y or N) _____

Date Completed 2/3/93
Yield 5 (GPM)
Stabilized Water Level 280
Disinfectant Used _____

Total Depth of Well 360'
Length of Test 1 HR.
Natural Flow (Rate) _____
Amount Used _____

Casing From 1 To 55
Size 6 1/4 Material P.V.C.
Weight/Schedule SDR 27

From _____ To _____
Size _____ Material _____
Weight/Schedule _____

From _____ To _____
Size _____ Material _____
Weight/Schedule _____

Gravel Pack

From _____ To _____

From _____ To _____

From _____ To _____

Hole size 10" from 0 to 55 ft.

6" from 55 to 360 ft.

_____ " from _____ to _____ ft.

Grout From 0 To 50+

From _____ To _____

From _____ To _____

Bore Hole Size 10" 2/4/93

Bore Hole Size _____

Bore Hole Size _____

Type Bentonite

Type _____

Type _____

Method Pressure Grouting

Method _____

Method _____

Water Zones or Screened Intervals

From 200 To 201

From _____ To _____

From _____ To _____

Mesh Size _____ Diam _____

Mesh Size _____ Diam _____

Mesh Size _____ Diam _____

From 340 To 341

From _____ To _____

From _____ To _____

Mesh Size _____ Diam _____

Mesh Size _____ Diam _____

Mesh Size _____ Diam _____

* Use Data *

Private Well: Domestic _____ Agricultural _____ Industrial _____ Monitoring _____
Public Well: Community _____ Non Community _____

* Abandonment Information *

Bored or Dug Wells

Casing Removed, Y or N?: _____
If Y, Depth to which casing was removed: _____
Depth and Type of Fill: _____
Source of Fill: _____
Bentonite Plugs: From _____ to _____ From _____ to _____

Wells other than Bored Wells

Casing removed, Y or N? _____
Depth to which casing was removed: _____
Applicable, depth(s), and type of gravel/sand fill: _____
Source of gravel or sand: _____
Cement: From _____ to _____ From _____ to _____

Method of permanently marking location: _____
 Installed watertight top
Suggest setting pump @ approx. 300 ft.

Jim Thompson / Thompson Building Corp

Bo. Selb


Holly Corera # 8

Stafford
17 → Holly Berry Rd. Drivers Log

ation
onwealth of
e Department

Depth Description of Formation or Sediment Remarks

0	10	Red Clay
10	45	Brown Clay
45	55	Light Brown Shale
55	64	Dark Brown Shale
64	360	Granite (Light Grey & Dark Grey)

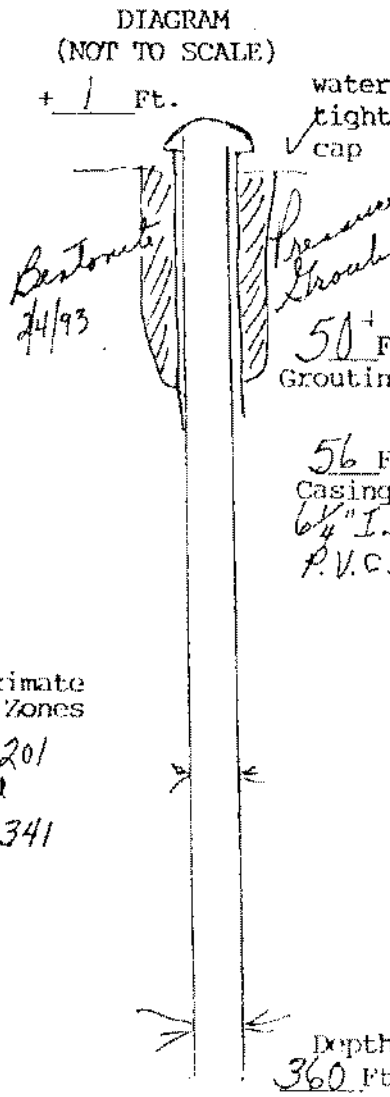

Approximate Water Zones
200 to 201
and
340 to 341

(User additional Sheets if necessary)

I certify that the information contained here is true and that this well was installed and constructed in accordance with the permit and further that the well complies with all applicable state and local regulations, ordinances and laws.

Name JOHN L. DANIELSON, JR., INC.
Address 4616 HOOD DRIVE
FREDERICKSBURG, VIRGINIA 22408
Phone (703) 898-6025 / 898-9355

Drillers Signature John L. Danielson
Date 2/19/93 Representing JOHN L. DANIELSON, JR., INC.

Virginia Contractors License Number _____