

Charles Klaff
Reverend Construction
11800 Wilderness Park Drive
Spotsylvania, Va 22553
972-1140

Commonwealth of Virginia
Uniform Water Well Completion Report

Owner: Ruby Klaff Tax Map ID 43-35 H
Address: 11800 Wilderness Park Drive YDH Permit WS-93-148
Spotsylvania, Va 22553 WWCB Permit _____
Phone: 972-1140 WWCB ID _____
Location: River's Edge #1 / Old Barn Rd - 1/4 mile S. of 6551 County: Stafford
1830 near N. D. Corns 6/9/93 Rob Snyder
Well Classification: IIIA IIIB IIIC IV 6/9/93 J. J. Thompson
Approx 1 Mile S. of 6551 Old Barn Well Data

General Information

Drilling Method: Air Rotary
Depth to Bedrock: 60'
Static Water Level: 70'
Well Disinfected (Y or N): _____

Date Completed: 9/2/93
Yield: 20 (GPM)
Stabilized Water Level: 120
Disinfectant Used: _____

Total Depth of Well: 240
Length of Test: 1 Hr.
Natural Flow (Rate): _____
Amount Used: _____

Casing

From +1 To 77
Size: 6 7/8" Material: P.V.C.
Weight/Schedule: SDR 27

From _____ To _____
Size _____ Material _____
Weight/Schedule _____

From _____ To _____
Size _____ Material _____
Weight/Schedule _____

Gravel Pack

From _____ To _____

From _____ To _____

From _____ To _____

Hole size: 10" from 0 to 60 ft.
Gravel: _____
From 0 To 50+
Bore Hole Size: 10" 9/7/93
Type: Bentonite
Method: Because Drilling

Hole size: 8 1/2" from 60 to 77 ft.
Gravel: _____
From _____ To _____
Bore Hole Size: _____
Type: _____
Method: _____

Hole size: 6 7/8" from 77 to 240 ft.
Gravel: _____
From _____ To _____
Bore Hole Size: _____
Type: _____
Method: _____

Water Zones or Screened Intervals

From 232 To 233
Mesh Size _____ Diam _____
From _____ To _____
Mesh Size _____ Diam _____

From _____ To _____
Mesh Size _____ Diam _____

* Use Data *

Private Well: Domestic Agricultural _____ Industrial _____ Monitoring _____
Public Well: Community _____ Non Community _____

* Abandonment Information *

Bored or Dug Wells

Casing Removed, Y or N?: _____
If Y, Depth to which casing was removed: _____
Depth and Type of Fill: _____
Source of Fill: _____
Bentonite Plugs: From _____ to _____ From _____ to _____

Wells other than Bored Wells

Casing removed, Y or N?: _____
Depth to which casing was removed: _____
Applicable, depth(s), and type of gravel/sand fill: _____
Source of gravel or sand: _____
Cement: From _____ to _____ From _____ to _____

Method of permanently marking location:
 Installed watertight top
Suggest setting pump @ approx. 140 ft.

Charles Klaff / Riverside Contractors

Ruby Klaff

Riverside # 1

Stafford

Old Farm Rd, near Hill Country
off 255 & 417

Drillers Log


Depth

Description of Formation or Sediment

Remarks

0	10	Red Clay
10	30	Micaceous formation / Red
30	60	Micaceous formation / Brown
60	77	Brown Shale
77	240	Blue Granite

DIAGRAM (NOT TO SCALE)

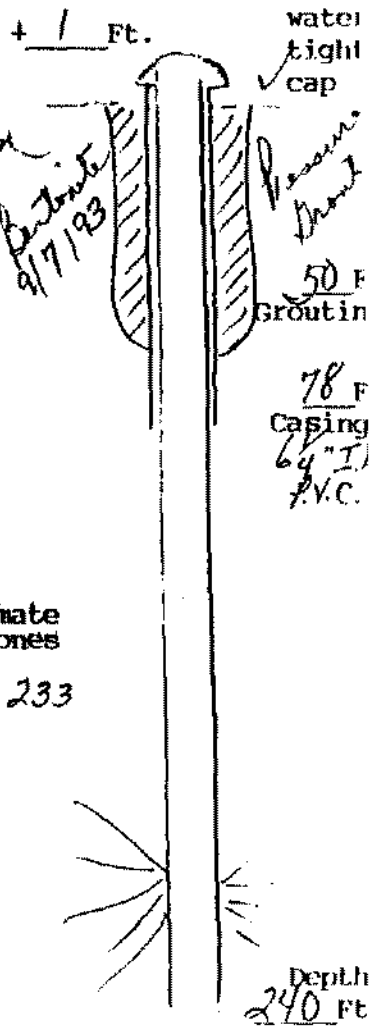

Approximate Water Zones

232 & 233

Depth 240 Ft.

(Use additional Sheets if necessary)

I certify that the information contained here is true and that this well was installed and constructed in accordance with the permit and further that the well complies with all applicable state and local regulations, ordinances and laws.

Name JOHN L. DANIELSON, JR., INC.
 Address 4616 HOOD DRIVE
FREDERICKSBURG, VIRGINIA 22408
 Phone (703) 898-6025 / 898-9355

Drillers Signature John L. Danielson, Jr.
 Date 9/11/83 Representing JOHN L. DANIELSON, JR., INC.

Virginia Contractors License Number CLASS A 2701 014084A H/H MWC