

Commonwealth of Virginia
Uniform Water Well Completion Report

Owner Debra & Richard Mieser
Address 13125 Oriole Drive
Beltzville, Md. 20705
Phone 1-301-572-2997
Location #65 Holly Corner Estates #4

Tax Map ID 43C 1-1
VDH Permit WS-93
VWCB Permit _____
VWCB ID _____
County Stafford
6/14/93 Rob Snyder
6/17/93 T.T. Thompson

Well Classification IIIA _____ IIIB IIIC _____ IV _____
* Well Data *

General Information

Drilling Method Air Rotary
Depth to Bedrock 56
Static Water Level 60
Well Disinfected (Y or N) _____

Date Completed 8/18/93
Yield 25 (GPM)
Stabilized Water Level 80
Disinfectant Used _____

Total Depth of Well 140'
Length of Test 1 Hr.
Natural Flow (Rate) _____
Amount Used _____

Casing

From 71 To 66
Size 6 3/4 Material P.V.C.
Weight/Schedule SDR 27

From _____ To _____
Size _____ Material _____
Weight/Schedule _____

From _____ To _____
Size _____ Material _____
Weight/Schedule _____

Gravel Pack

From _____ To _____

From _____ To _____

From _____ To _____

Hole size

10" from 0 to 60 ft.

7 7/8" from 60 to 66 ft.

6 3/8" from 66 to 140 ft.

Grout

From 0 To 60
Bore Hole Size 10" 8/25/93
Type Bentonite
Method Pressure Grouting

From _____ To _____
Bore Hole Size _____
Type _____
Method _____

From _____ To _____
Bore Hole Size _____
Type _____
Method _____

Water Zones or Screened Intervals

From 130 To 131
Mesh Size _____ Diam _____
From _____ To _____
Mesh Size _____ Diam _____

From _____ To _____
Mesh Size _____ Diam _____

* Use Data *

Private Well: Domestic Agricultural _____ Industrial _____ Monitoring _____
Public Well: Community _____ Non Community _____

* Abandonment Information *

Bored or Dug Wells

Casing Removed, Y or N? _____
If Y, Depth to which casing was removed: _____
Depth and Type of Fill: _____
Source of Fill: _____
Bentonite Plugs: From _____ to _____ From _____ to _____

Wells other than Bored Wells

Casing removed, Y or N? _____
Depth to which casing was removed: _____
Applicable, depth(s), and type of gravel/sand fill: _____
Source of gravel or sand: _____
Cement: From _____ to _____ From _____ to _____

Method of permanently marking location: _____
 Installed watertight top
Suggest setting pump @ approx. 100 ft.

COOPERATIVE
FEDERATION


Therault

Tabily Log Homes

Maric

Holly Corner Dr #4
off 6554 Holly Corner Drive Drillers Log

Depth	Description of Formation or Sediment	Remarks
0	10	Red Clay
10	40	Micaceous formation / Red
40	56	Micaceous formation / Brown
56	66	Brown Shale
66	140	Blue Granite

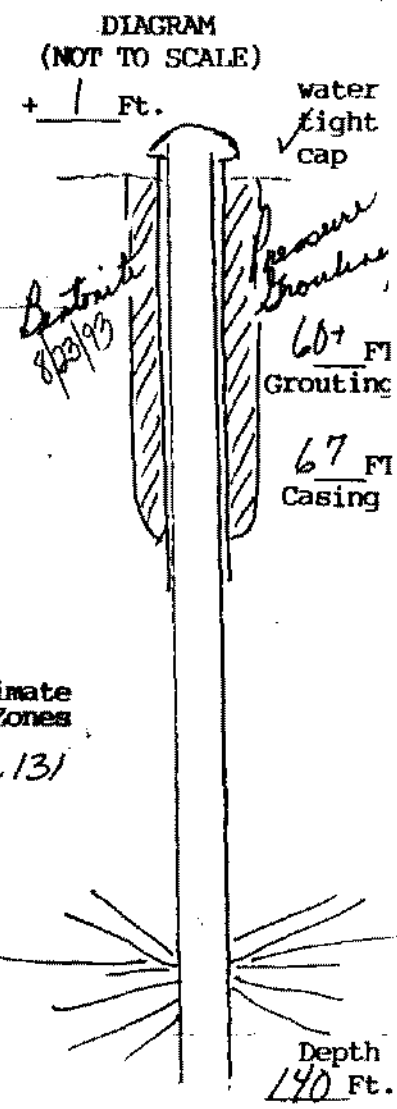

Approximate
Water Zones
130 to 131

(User additional Sheets if necessary)

I certify that the information contained here is true and that this well was installed and constructed in accordance with the permit and further that the well complies with all applicable state and local regulations, ordinances and laws.

Name JOHN L. DANIELSON, JR., INC.
 Address 4616 HOOD DRIVE
FREDERICKSBURG, VIRGINIA 22408
 Phone (703) 898-6025 / 898-9355
 Drillers Signature *John L. Danielson, Jr.*
 Date 8/23/93 Representing JOHN L. DANIELSON, JR., INC.
 Virginia Contractors License Number CLASS A 2701 014084A H/H WVC