

**Commonwealth of Virginia
Uniform Water Well Completion Report**

(#2)

Owner Gary Lauer
 Address 220 Memory Lane
Dalmonouth, Va. 22406
 Phone 752-4024
 Location 17-5655 R on Memory Lane -> House on left

Tax Map ID 43-51 F
 VDH Permit WS-93-164
 VWCB Permit _____
 VWCB ID _____
 County Stafford
Daniel J. Goshorn

Well Classification IIIA _____ IIIB _____ IIIC IV _____
 * Well Data *

General Information

Drilling Method Auger (Boring Rig) Date Completed 9/20/93 Total Depth of Well 53
 Depth to Bedrock _____ Yield approx 2 GPM @ 100' installation Length of Test _____
 Static Water Level 30 Stabilized Water Level 45 Natural Flow (Rate) _____
 Well Disinfected (Y or N) _____ Disinfectant Used _____ Amount Used _____
Water rose 3' in 30 min. @ time of installation.
 Casing 24" Curbing holed 23.5 gal of water per ft.
 From 1 To 53 From _____ To _____ From _____ To _____
 Size 24" ID Material Concrete Size _____ Material _____ Size _____ Material _____
 Weight/Schedule _____ Weight/Schedule _____ Weight/Schedule _____
Bored through casing material from 30' to 53'

Gravel Pack

From _____ To _____ From _____ To _____ From _____ To _____

Hole size

39" from 0 to 20ft. 29" from 20 to 53ft. _____ " from _____ to _____ ft.

Grout

From _____ To _____ From _____ To _____ From _____ To _____

Bore Hole Size

Bore Hole Size _____ Bore Hole Size _____ Bore Hole Size _____

Type

Type _____ Type _____ Type _____

Method

Method _____ Method _____ Method _____

Water Zones or Screened Intervals

From <u>30</u> To <u>32</u>	From _____ To _____	From _____ To _____
Mesh Size _____ Diam _____	Mesh Size _____ Diam _____	Mesh Size _____ Diam _____
From <u>40</u> To <u>45</u>	From _____ To _____	From _____ To _____
Mesh Size _____ Diam _____	Mesh Size _____ Diam _____	Mesh Size _____ Diam _____

* Use Data *

Private Well: Domestic Agricultural _____ Industrial _____ Monitoring _____
 Public Well: Community _____ Non Community _____

* Abandonment Information *

Bored or Dug Wells

Casing Removed, Y or N? _____
 If Y, Depth to which casing was removed: _____
 Depth and Type of Fill: _____
 Source of Fill _____
 Bentonite Plugs: From _____ to _____ From _____ to _____

Wells other than Bored Wells

Casing removed, Y or N? _____
 Depth to which casing was removed: _____
 Applicable, depth(s), and type of gravel/sand fill: _____
 Source of gravel or sand: _____
 Cement: From _____ to _____ From _____ to _____

Method of permanently marking location:


Installed watertight top concrete "Shoebox" lid
 Suggest setting pump @ approx. 5 ft. off bottom

Gary Payne
Stafford

Murray Lane off 655 E 17

* Drillers Log *

Depth Description of Formation or Sediment Remarks

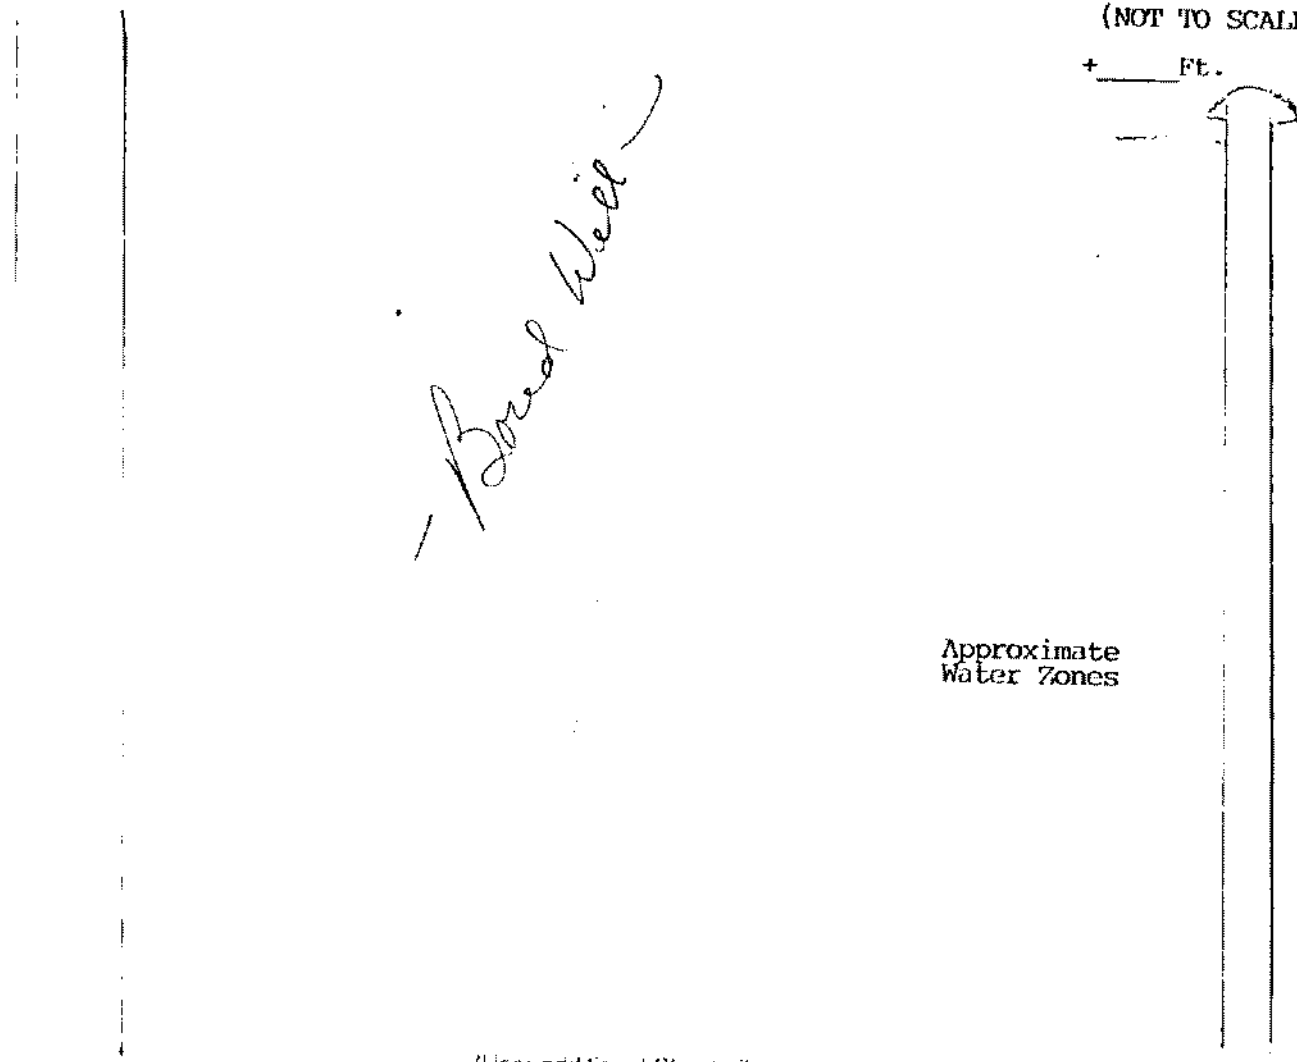

(Use additional Sheets if necessary)

I certify that the information contained here is true and that this well was installed and constructed in accordance with the permit and further that the well complies with all applicable state and local regulations, ordinances and laws.

Name: JOHN L. DANIELSON, JR., INC.
Address: 4616 HOOD DRIVE
FREDERICKSBURG, VIRGINIA 22408
Phone: (703) 898-6025 / 898-9355

Signature: John L. Danielson, Jr.
Date: 9/22/93 Representing JOHN L. DANIELSON, JR., INC.

Professional Contractors License Number CLASS A 2701 014084A H/H WWC