

**Commonwealth of Virginia
Uniform Water Well Completion Report**

Owner Dee & Bonnie Harrison
 Address F.O. Box 5730
Baltimore, Co. 22403
 Phone 752-4851 / F. 371-2736
 Location Holly Corner Estates # 6
 183A
 Well Classification IIIA IIIB IIIC IV
 * Well Data *

Tax Map ID 43C-1-6
 VDH Permit 05-93-253
 VWCB Permit _____
 VWCB ID _____
 County Stafford
10/13/93 Daniel Gasalyne
10/15/93 J.J. Thompson

General Information

Drilling Method Air Rotary
 Depth to Bedrock 65
 Static Water Level approx 40'
 Well Disinfected (Y or N) _____

Date Completed 12/14/93
 Yield 20 (GPM)
 Stabilized Water Level 77.80'
 Disinfectant Used _____

Total Depth of Well 240
 Length of Test Approx 1 Hr.
 Natural Flow (Rate) _____
 Amount Used _____

Casing

From 1 To 65
 Size 6 1/4" Material P.V.C.
 Weight/Schedule SDR 27

From 60 To 200
 Size 4" Material P.V.C.
 Weight/Schedule Sch 40

From 220 To 240
 Size 4" Material P.V.C.
 Weight/Schedule Sch. 40

Gravel Pack

From _____ To _____

From _____ To _____

From _____ To _____

Hole size

10" from 0 to 55ft.

7 7/8" from 55 to 65 ft.

6 1/2" from 65 to 240 ft.

Grout

From 0 To 50' 12/16/93

From _____ To _____

From _____ To _____

Bore Hole Size

Type Bentonite

Bore Hole Size

Type _____

Bore Hole Size

Type _____

Method

Pressure Grouting

Method

Method

Water Zones or Screened Intervals

From 200 To 220
 Mesh Size .020 Diam 4" (P.V.C.)
 From _____ To _____
 Mesh Size _____ Diam _____

approx water zone
 From 211 To 212
 Mesh Size _____ Diam _____
 From _____ To _____
 Mesh Size _____ Diam _____

From _____ To _____
 Mesh Size _____ Diam _____
 From _____ To _____
 Mesh Size _____ Diam _____

*** Use Data ***

Private Well: Domestic Agricultural _____ Industrial _____ Monitoring _____
 Public Well: Community _____ Non Community _____

*** Abandonment Information ***

Bored or Dug Wells

Casing Removed, Y or N? _____
 If Y, Depth to which casing was removed: _____
 Depth and Type of Fill: _____
 Source of Fill: _____
 Bentonite Plugs: From _____ to _____ From _____ to _____

Wells other than Bored Wells

Casing removed, Y or N? _____
 Depth to which casing was removed: _____
 Applicable, depth(s), and type of gravel/sand fill: _____
 Source of gravel or sand: _____
 Cement: From _____ to _____ From _____ to _____

Method of permanently marking location:

Installed watertight top
 Suggest setting pump @ approx 200 ft.
You will encounter 4" casing @ approx 60 Ft.
Suggest keeping tongue arrestors & centralizers out of 4" casing


Bert & Boine Harrison
Holly Corner Estate # 6
Shefford # 655

* Drillers Log *

Depth Description of Formation or Sediment Remarks

0	10	Red Clay
10	30	Mucous formation / Brown
30	65	Soft Brown Shale
65	240	Soft Blue Shale

set 4" P.V.C. casing
 and screen -
 as per - due
 to the softness
 of the formation. *Bentonite 12/16/93*

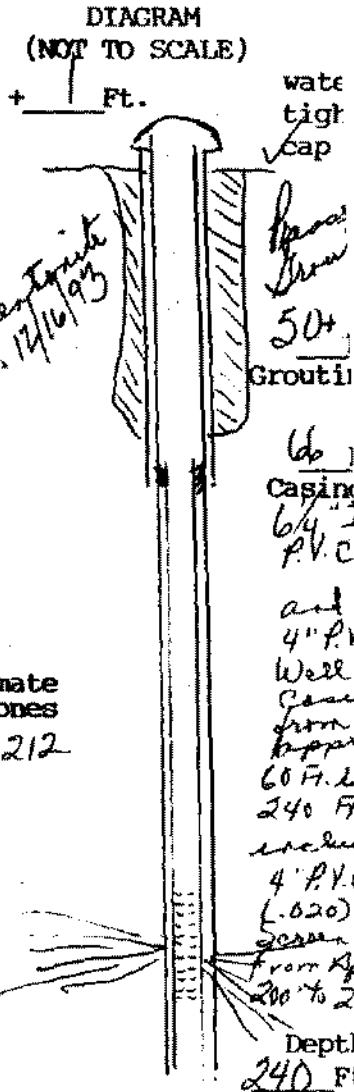

Approximate
 Water Zones
 211 to 212



(User additional Sheets if necessary)

I certify that the information contained here is true and that this well was installed and constructed in accordance with the permit and further that the well complies with all applicable state and local regulations, ordinances and laws.

Name JOHN L. DANIELSON, JR., INC.
 Address 4616 HOOD DRIVE
FREDERICKSBURG, VIRGINIA 22408
 Phone (703) 898-6025 / 898-9355

Drillers Signature *John L. Danielson, Jr.*
 Date 12/16/93 representing JOHN L. DANIELSON, JR., INC.

Virginia Contractors License Number CLASS A 2701 014084A H/H WVC