

**Commonwealth of Virginia
Uniform Water Well Completion Report**

Free Home
P.O. Box 1033
Spotsylvania, Va.
891-1248

43C-1-3

Owner _____
Address _____

Tax Map ID 43C-3
VDH Permit WIS-93-274
VWCB Permit _____
VWCB ID _____

Phone _____
Location Holly Corner Estates #3 (Holly Berry Rd.)

County STAFFORD
9/20/93 Clayton B. Wright
9/21/93 J.J. Thompson

Well Classification IIIA IIIB IIIC IV
*1 Mile South of intersection of 654 & 655. Well Data **
3/10 Miles West of 655

General Information
Drilling Method Air Rotary
Depth to Bedrock 54'
Static Water Level 30'
Well Disinfected (Y or N) _____

Date Completed 4/5/94
Yield 60 (GPM)
Stabilized Water Level 60'
Disinfectant Used _____

Total Depth of Well 300'
Length of Test approx 1 Hr.
Natural Flow (Rate) _____
Amount Used _____

Casing
From +1 To 93
Size 6 1/4" Material P.V.C.
Weight/Schedule SDR 27

From 80 To 160
Size 4" Material P.V.C.
Weight/Schedule Sch. 40

From 180 To 300
Size 4" Material P.V.C.
Weight/Schedule Sch 40

Gravel Pack
From _____ To _____
Hole size
10" from 0 to 93 ft.
Grout
From 0 To 50' FT
Bore Hole Size 10"
Type Bentonite
Method Pressure Grouting

From _____ To _____
6 1/8" from 93 to 20 ft.
From _____ To _____
Bore Hole Size _____
Type _____
Method _____

From _____ To _____
" from _____ to _____ ft.
From _____ To _____
Bore Hole Size _____
Type _____
Method _____

Water Zones or Screened Intervals
From _____ To _____
Mesh Size .020 Diam 4" (P.V.C.)
From _____ To _____
Mesh Size _____ Diam _____

approx water zone
From 120 To 121
Mesh Size _____ Diam _____
From 170 To 171
Mesh Size _____ Diam _____

From _____ To _____
Mesh Size _____ Diam _____
From _____ To _____
Mesh Size _____ Diam _____

* Use Data *

Private Well: Domestic Agricultural _____ Industrial _____ Monitoring _____
Public Well: Community _____ Non Community _____

* Abandonment Information *

Bored or Dug Wells
Casing Removed, Y or N? _____
If Y, Depth to which casing was removed: _____
Depth and Type of Fill: _____
Source of Fill _____
Bentonite Plugs: From _____ to _____ From _____ to _____

Wells other than Bored Wells
Casing removed, Y or N? _____
Depth to which casing was removed: _____
Applicable, depth(s), and type of gravel/sand fill: _____
Source of gravel or sand: _____
Cement: From _____ to _____ From _____ to _____

Method of permanently marking location:
 Installed watertight top
Suggest setting pump @ approx. 80 ft.
you will encounter 4" casing @ approx. 100'

K.P.
933178


Rose Tree Homes
Holly Corner Est #3
Stafford
Holly Berry Road
 Drillers Log

150 C OLE GREEN
 4118

Depth Description of Formation or Sediment Remarks

0	10	Red Clay
10	54	Brown Clay
54	93	Soft Brown Rock
93	200	Light Grey Rock

set 4" P.V.C. casing
 & scrapers due
 to soft area
 in the formation.

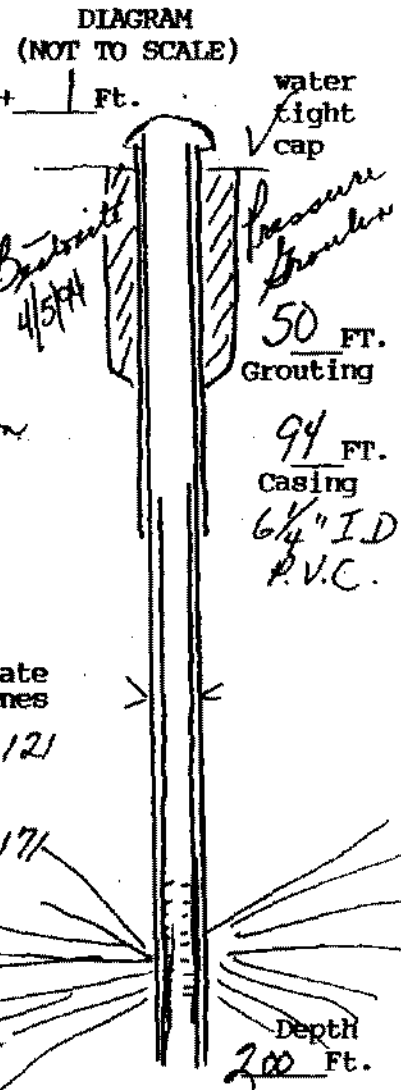

Approximate
 Water Zones

120 to 121
 and
 170 to 171

(User additional Sheets if necessary)

I certify that the information contained here is true and that this well was installed and constructed in accordance with the permit and further that the well complies with all applicable state and local regulations, ordinances and laws.

Name JOHN L. DANIELSON, JR., INC.
 Address 4616 HOOD DRIVE
FREDERICKSBURG, VIRGINIA 22408
 Phone (703) 898-6025 / 898-9355

Drillers Signature John L. Danielson, Jr.
 Date 4/3/94 Representing JOHN L. DANIELSON, JR., INC.

Virginia Contractors License Number CLASS A 2701 014084A H/H WWC