

**Commonwealth of Virginia  
Uniform Water Well Completion Report**

Owner To Sale  
Address \_\_\_\_\_

Tax Map ID 43C-1-11  
VDH Permit W5-93-94  
VWCB Permit \_\_\_\_\_  
VWCB ID \_\_\_\_\_  
County Stafford

Phone \_\_\_\_\_  
Location Holly Corners # 11 (Corner Lot)

4/5/93 Perk Snyder  
4/7/93 T.T Thompson

Well Classification IIIA IIIB  IIIC IV  
2M South Intersection of 655 & #17 Well Data \*  
2/10 M. North #655

**General Information**  
Drilling Method 200  
Depth to Bedrock 33  
Static Water Level 30  
Well Disinfected (Y or N) \_\_\_\_\_

Date Completed 6/23/93  
Yield 70+ (GPM)  
Stabilized Water Level 80  
Disinfectant Used \_\_\_\_\_

Total Depth of Well 200  
Length of Test 1 Hr.  
Natural Flow (Rate) \_\_\_\_\_  
Amount Used \_\_\_\_\_

**Casing**  
From +1 To 64  
Size 6.4 Material P.V.C.  
Weight/Schedule SDR 27

From \_\_\_\_\_ To \_\_\_\_\_  
Size \_\_\_\_\_ Material \_\_\_\_\_  
Weight/Schedule \_\_\_\_\_

From \_\_\_\_\_ To \_\_\_\_\_  
Size \_\_\_\_\_ Material \_\_\_\_\_  
Weight/Schedule \_\_\_\_\_

**Gravel Pack**  
From \_\_\_\_\_ To \_\_\_\_\_  
Hole size 10" from 0 to 64 ft.  
Grout From 0 To 60  
Bore Hole Size 10" 6/24/93  
Type Bentonite  
Method Pressure Grouting

From \_\_\_\_\_ To \_\_\_\_\_  
Hole size 6.8" from 64 to 200 ft.  
From \_\_\_\_\_ To \_\_\_\_\_  
Bore Hole Size \_\_\_\_\_  
Type \_\_\_\_\_  
Method \_\_\_\_\_

From \_\_\_\_\_ To \_\_\_\_\_  
Hole size \_\_\_\_\_ from \_\_\_\_\_ to \_\_\_\_\_ ft.  
From \_\_\_\_\_ To \_\_\_\_\_  
Bore Hole Size \_\_\_\_\_  
Type \_\_\_\_\_  
Method \_\_\_\_\_

**Water Zones or Screened Intervals**  
From 145 To 146  
Mesh Size \_\_\_\_\_ Diam \_\_\_\_\_  
From 180 To 181  
Mesh Size \_\_\_\_\_ Diam \_\_\_\_\_

From \_\_\_\_\_ To \_\_\_\_\_  
Mesh Size \_\_\_\_\_ Diam \_\_\_\_\_  
From \_\_\_\_\_ To \_\_\_\_\_  
Mesh Size \_\_\_\_\_ Diam \_\_\_\_\_

From \_\_\_\_\_ To \_\_\_\_\_  
Mesh Size \_\_\_\_\_ Diam \_\_\_\_\_  
From \_\_\_\_\_ To \_\_\_\_\_  
Mesh Size \_\_\_\_\_ Diam \_\_\_\_\_

\* Use Data \*

Private Well: Domestic  Agricultural \_\_\_\_\_ Industrial \_\_\_\_\_ Monitoring \_\_\_\_\_  
Public Well: Community \_\_\_\_\_ Non Community \_\_\_\_\_

\* Abandonment Information \*

**Bored or Dug Wells**  
Casing Removed, Y or N? \_\_\_\_\_  
If Y, Depth to which casing was removed: \_\_\_\_\_  
Depth and Type of Fill: \_\_\_\_\_  
Source of Fill: \_\_\_\_\_  
Bentonite Plugs: From \_\_\_\_\_ to \_\_\_\_\_ From \_\_\_\_\_ to \_\_\_\_\_


**Wells other than Bored Wells**  
Casing removed, Y or N? \_\_\_\_\_  
Depth to which casing was removed: \_\_\_\_\_  
Applicable, depth(s), and type of gravel/sand fill: \_\_\_\_\_  
Source of gravel or sand: \_\_\_\_\_  
Cement: From \_\_\_\_\_ to \_\_\_\_\_ From \_\_\_\_\_ to \_\_\_\_\_

Method of permanently marking location: \_\_\_\_\_  
 Installed watertight top  
Suggest setting pump @ approx. 100 ft.

New Century  
Holly Cross #11

\* Drillers Log \*

Depth	Description of Formation or Sediment	Remarks
0 33	Sandy Brown Clay	
33 90	Dark Grey Rock	
90 200	Light Grey Rock	

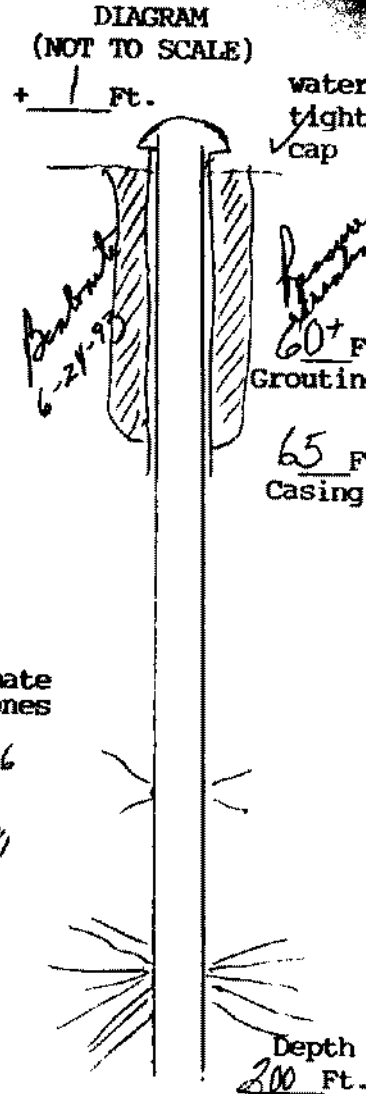

Approximate Water Zones

145 to 146  
 and  
 180 to 181

(User additional Sheets if necessary)

I certify that the information contained here is true and that this well was installed and constructed in accordance with the permit and further that the well complies with all applicable state and local regulations, ordinances and laws.

Name JOHN L. DANIELSON, JR., INC.  
 Address 4616 HOOD DRIVE  
FREDERICKSBURG, VIRGINIA 22408  
 Phone (703) 898-6025 / 898-9355

Drillers Signature John L. Danielson, Pres  
 Date 6/24/93 Representing JOHN L. DANIELSON, JR., INC.

Virginia Contractors License Number CLASS A 2701 014084A H/H WWC